


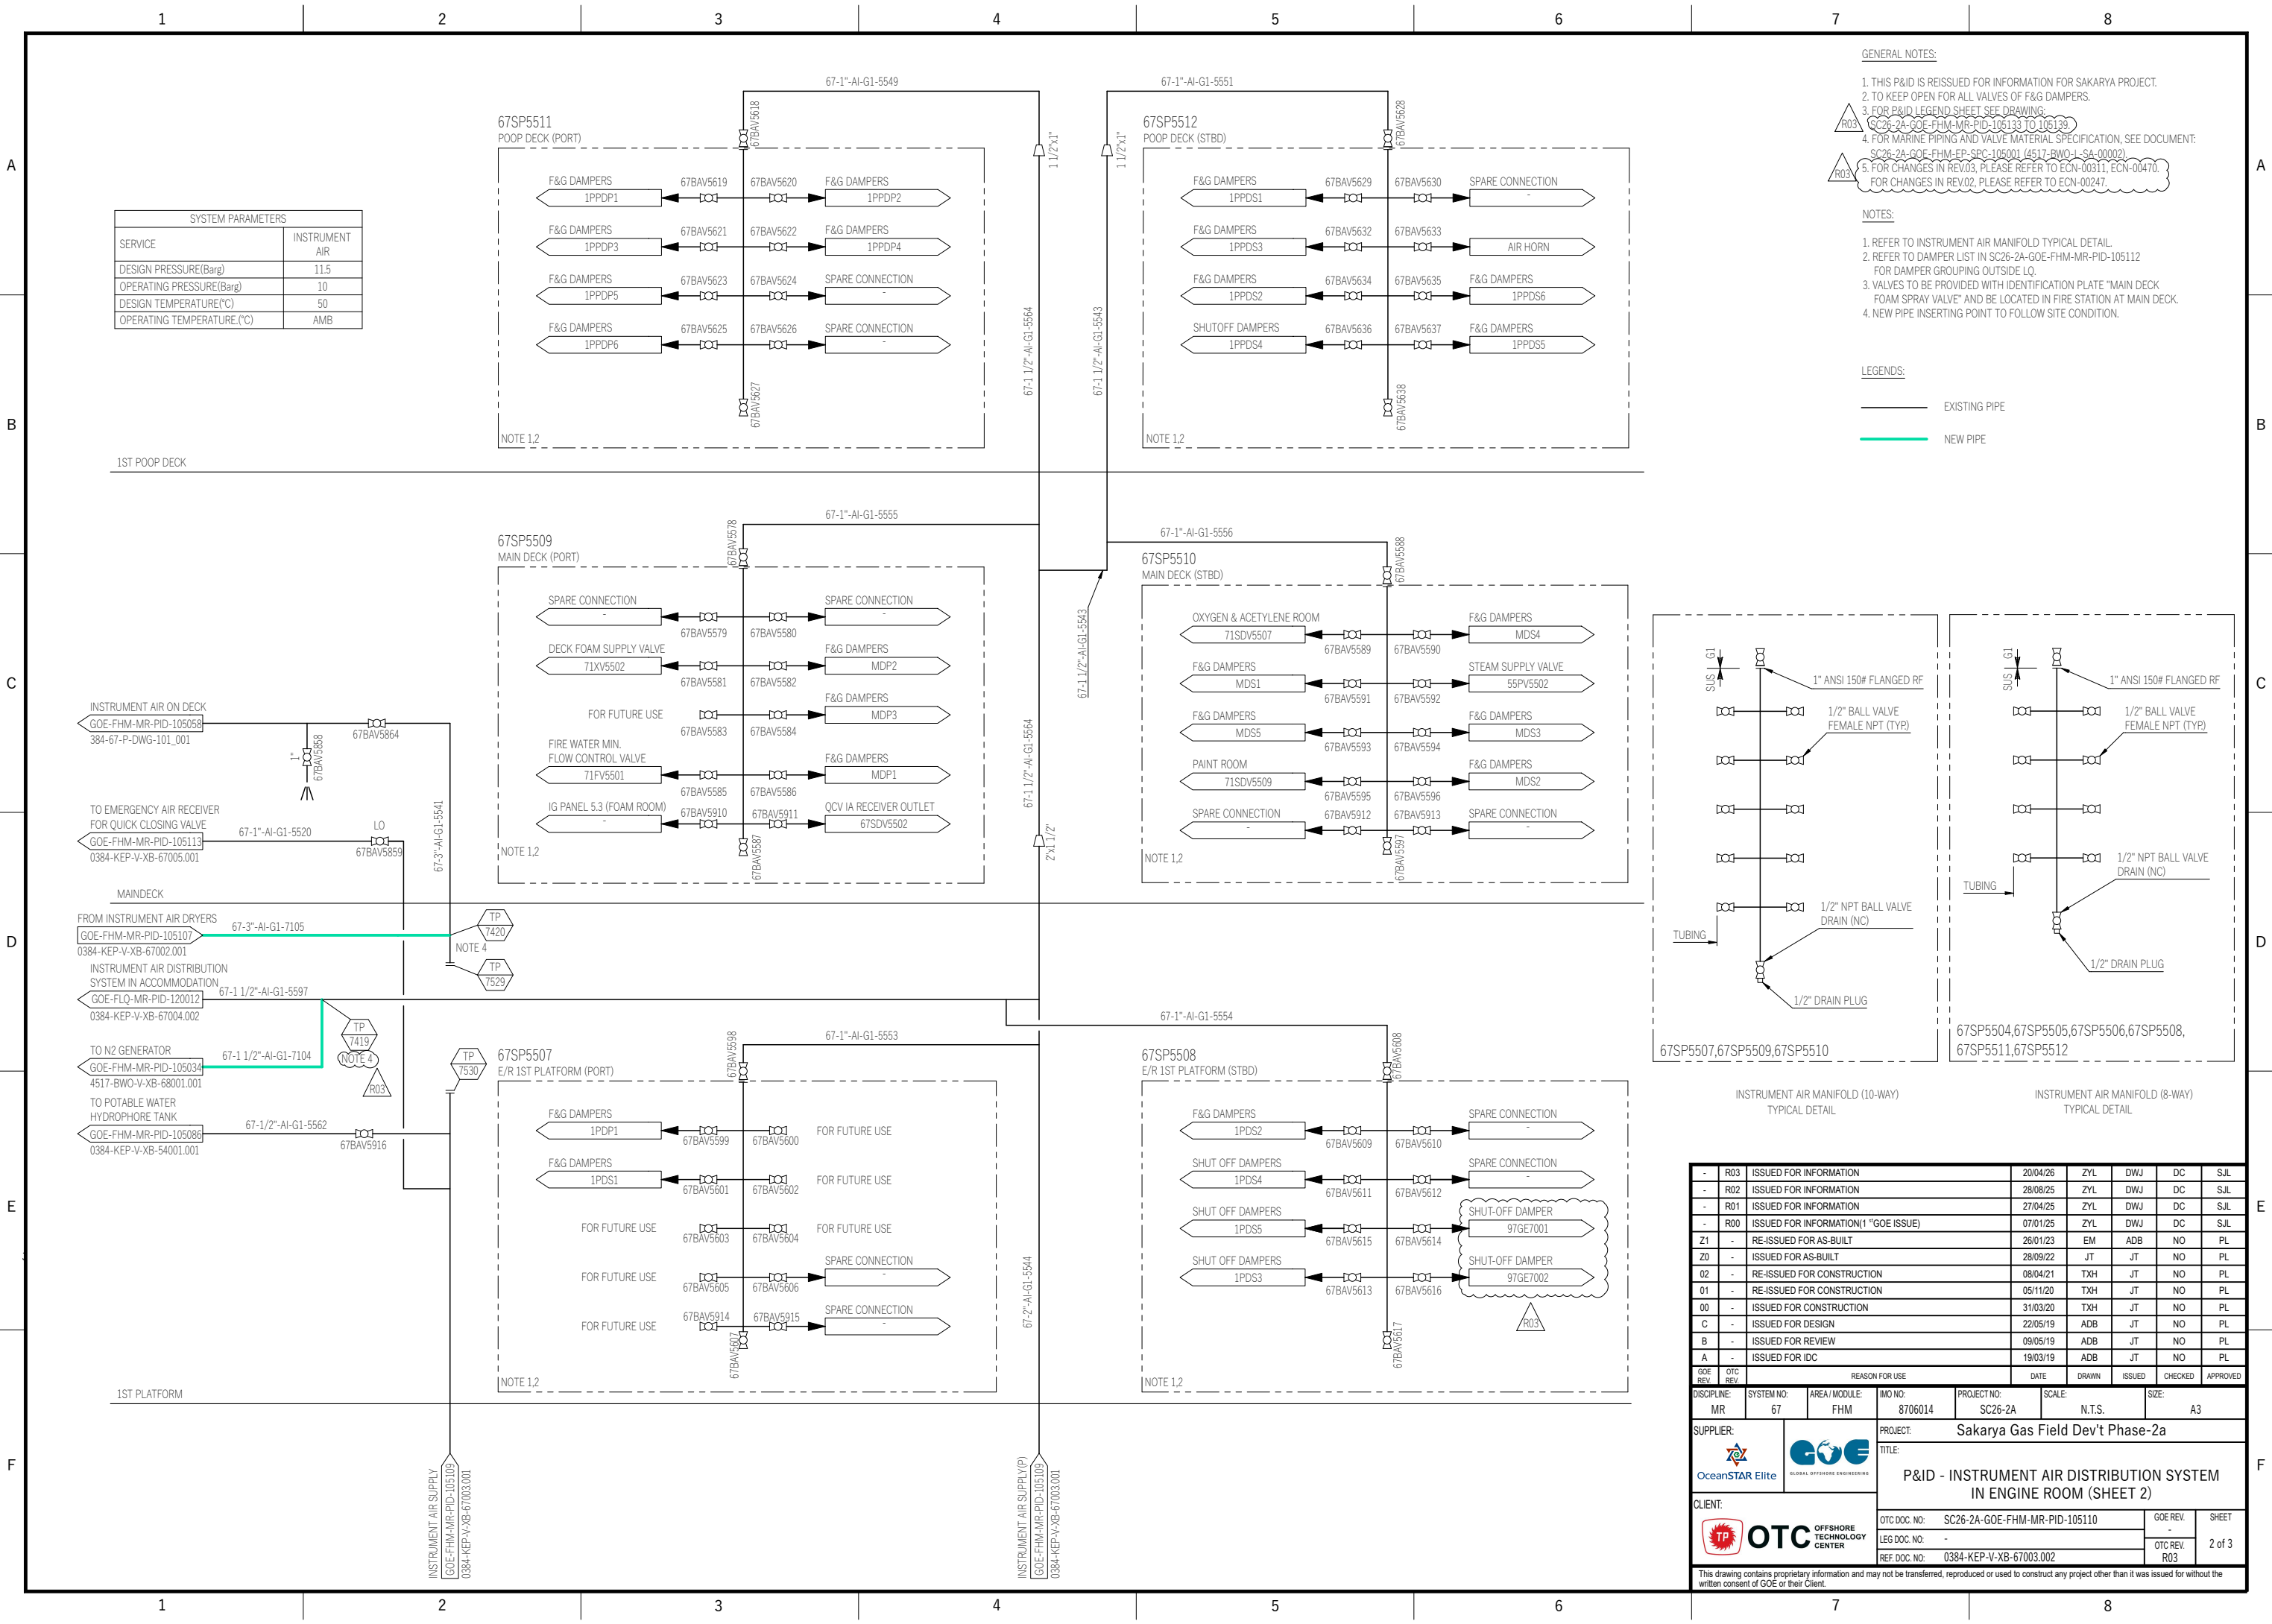


SYSTEM PARAMETERS	
SERVICE	INSTRUMENT AIR
DESIGN PRESSURE(Barg)	11.5
OPERATING PRESSURE(Barg)	10
DESIGN TEMPERATURE(°C)	50
OPERATING TEMPERATURE(°C)	AMB

- GENERAL NOTES:
- THIS P&ID IS REISSUED FOR INFORMATION FOR SAKARYA PROJECT.
 - TO KEEP OPEN FOR ALL VALVES OF F&G DAMPERS.
 - FOR P&ID LEGEND SHEET SEE DRAWING: SC26-2A-GOE-FHM-MR-PID-105133 TO 105138
 - FOR MARINE PIPING AND VALVE MATERIAL SPECIFICATION, SEE DOCUMENT: SC26-2A-GOE-FHM-EP-SPC-105001 (4517-BWO-I-SA-00002)
 - FOR CHANGES IN REV.03, PLEASE REFER TO ECN-00311, ECN-00470. FOR CHANGES IN REV.02, PLEASE REFER TO ECN-00247.

- NOTES:
- REFER TO INSTRUMENT AIR MANIFOLD TYPICAL DETAIL.
 - REFER TO DAMPER LIST IN SC26-2A-GOE-FHM-MR-PID-105112 FOR DAMPER GROUPING OUTSIDE LQ.
 - VALVES TO BE PROVIDED WITH IDENTIFICATION PLATE "MAIN DECK FOAM SPRAY VALVE" AND BE LOCATED IN FIRE STATION AT MAIN DECK.
 - NEW PIPE INSERTING POINT TO FOLLOW SITE CONDITION.

- LEGENDS:
- EXISTING PIPE
 - NEW PIPE

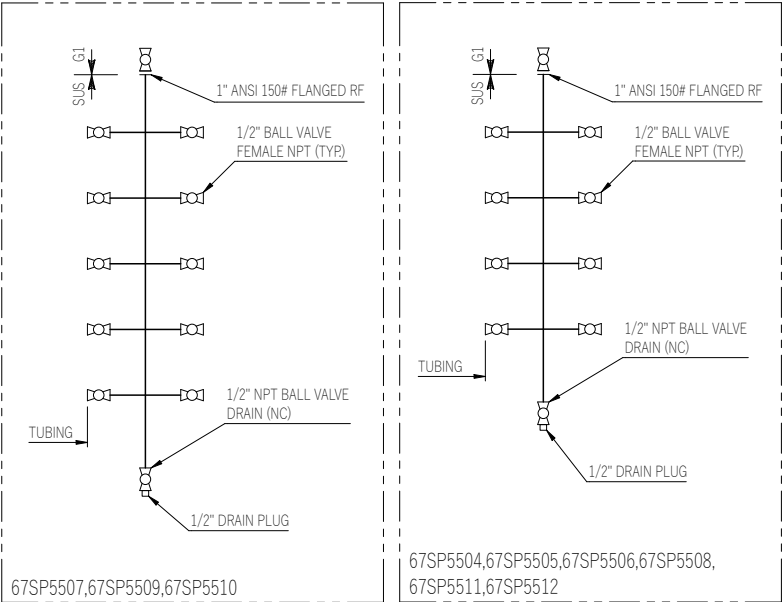

INSTRUMENT AIR MANIFOLD (10-WAY) TYPICAL DETAIL

INSTRUMENT AIR MANIFOLD (8-WAY) TYPICAL DETAIL

-	R03	ISSUED FOR INFORMATION	20/04/26	ZYL	DWJ	DC	SJL
-	R02	ISSUED FOR INFORMATION	28/08/25	ZYL	DWJ	DC	SJL
-	R01	ISSUED FOR INFORMATION	27/04/25	ZYL	DWJ	DC	SJL
-	R00	ISSUED FOR INFORMATION (1 "GOE ISSUE)	07/01/25	ZYL	DWJ	DC	SJL
Z1	-	RE-ISSUED FOR AS-BUILT	26/01/23	EM	ADB	NO	PL
Z0	-	ISSUED FOR AS-BUILT	28/09/22	JT	JT	NO	PL
02	-	RE-ISSUED FOR CONSTRUCTION	08/04/21	TXH	JT	NO	PL
01	-	RE-ISSUED FOR CONSTRUCTION	05/11/20	TXH	JT	NO	PL
00	-	ISSUED FOR CONSTRUCTION	31/03/20	TXH	JT	NO	PL
C	-	ISSUED FOR DESIGN	22/05/19	ADB	JT	NO	PL
B	-	ISSUED FOR REVIEW	09/05/19	ADB	JT	NO	PL
A	-	ISSUED FOR IDC	19/03/19	ADB	JT	NO	PL

GOE REV.	OTC REV.	REASON FOR USE				DATE	DRAWN	ISSUED	CHECKED	APPROVED
DISCIPLINE:		SYSTEM NO.:	AREA / MODULE:	IMO NO.:	PROJECT NO.:	SCALE:	SIZE:			
MR		67	FHM	8706014	SC26-2A	N.T.S.	A3			
SUPPLIER:			PROJECT: Sakarya Gas Field Dev't Phase-2a							
 OceanSTAR Elite			 GLOBAL OFFSHORE ENGINEERING							
CLIENT:			TITLE: P&ID - INSTRUMENT AIR DISTRIBUTION SYSTEM IN ENGINE ROOM (SHEET 2)							
 OTC OFFSHORE TECHNOLOGY CENTER			OTC DOC. NO. SC26-2A-GOE-FHM-MR-PID-105110					GOE REV. -		SHEET
			LEG DOC. NO. -					OTC REV. R03		2 of 3
			REF DOC. NO. 0384-KEP-V-XB-67003.002							
This drawing contains proprietary information and may not be transferred, reproduced or used to construct any project other than it was issued for without the written consent of GOE or their Client.										

This drawing contains proprietary information and may not be transferred, reproduced or used to construct any project other than it was issued for without the written consent of GOE or their Client.