

12345678

A


B

C

D

E

F

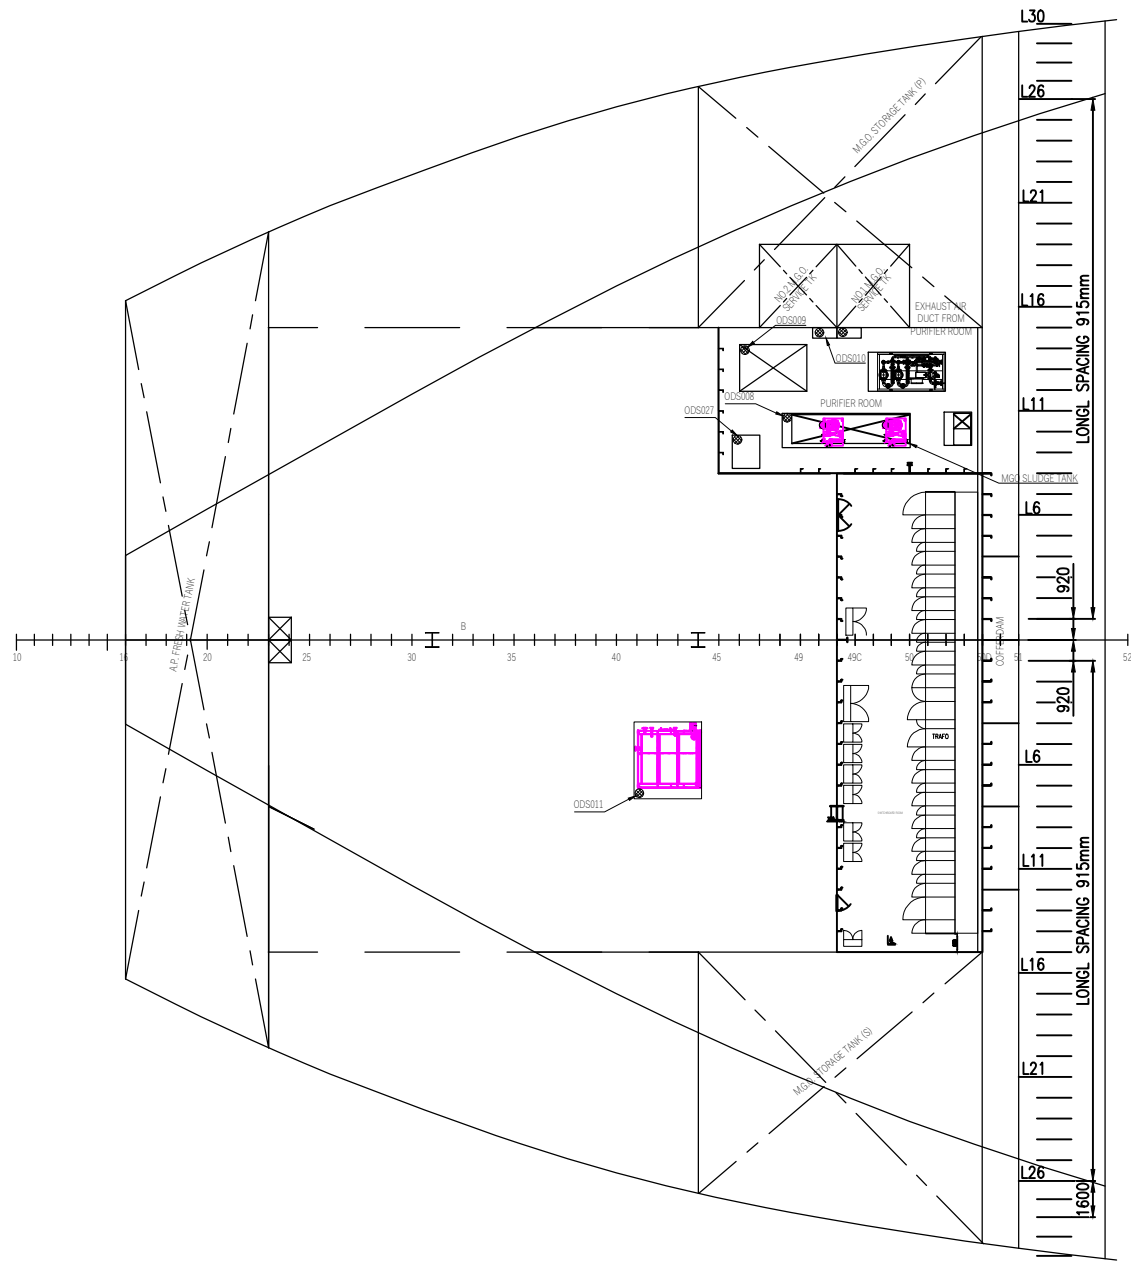

PLAN AT 2nd PLATFORM DECK


GENERAL NOTES:

1. THIS P&ID IS REISSUED FOR INFORMATION FOR SAKARYA PROJECT.
2. NO CHANGE IN SYSTEM.
3. FOR P&ID LEGEND SHEET SEE DRAWING:
SC26-2A-GOE-FGN-PE-PID-100018, SC26-2A-GOE-FGN-PE-PID-100021 TO 100031.
4. FOR MARINE PIPING AND VALVE MATERIAL SPECIFICATION, SEE DOCUMENT:
SC26-2A-GOE-FHM-EP-SPC-105001 (4517-BWO-L-SA-00002).



LEGEND:

- COAMING SCUPPER

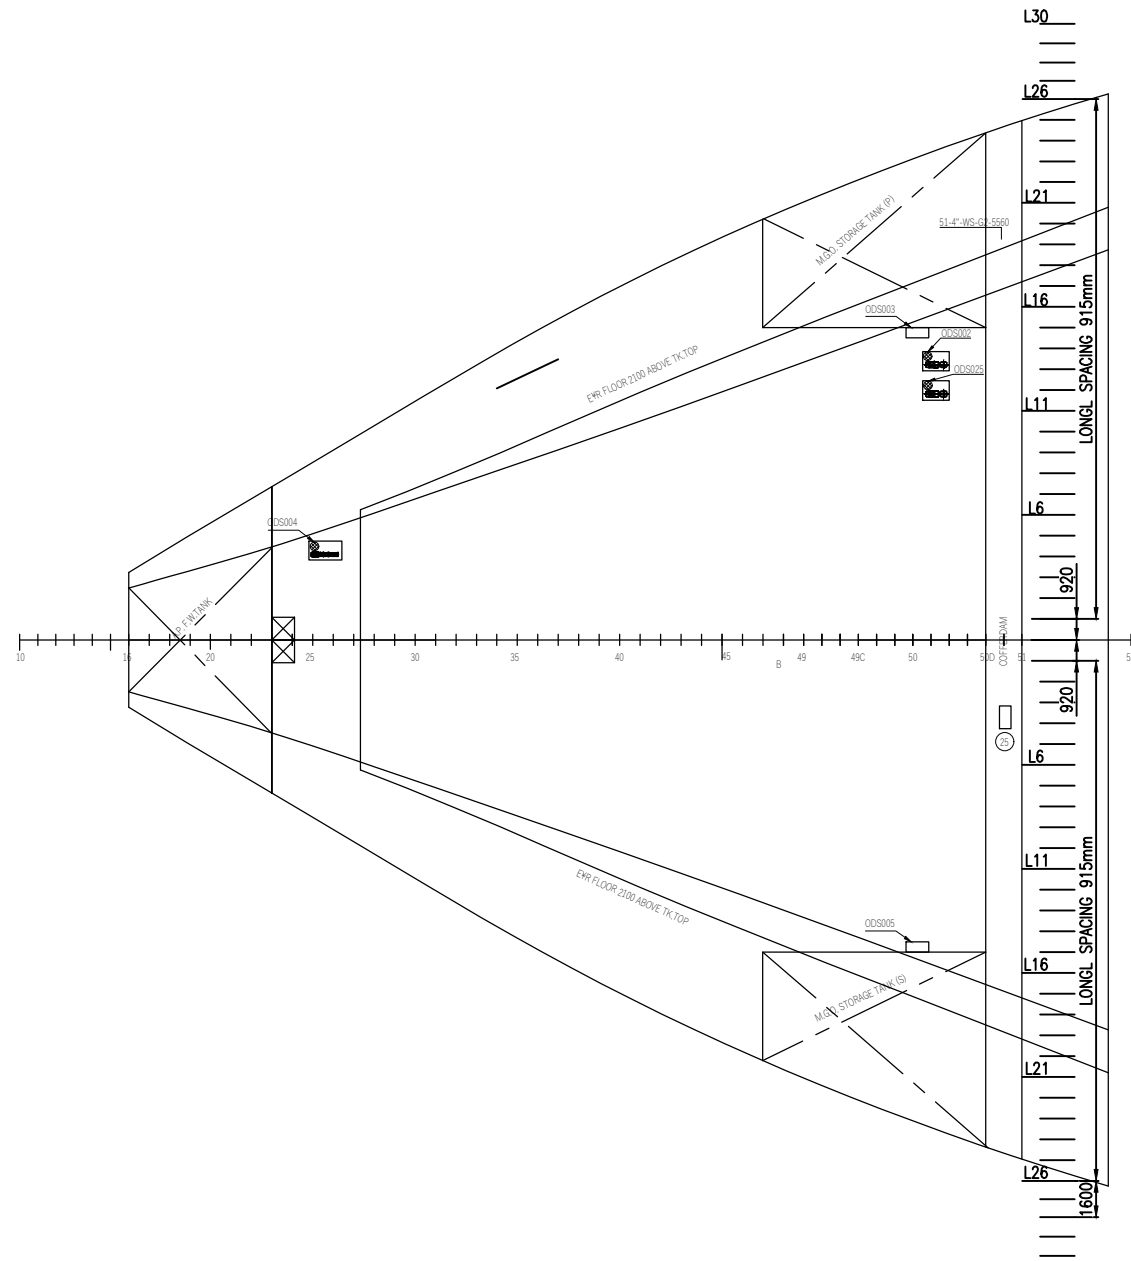

PLAN AT ER FLOOR (2100MM ABOVE TANK TOP)

-	R02	ISSUED FOR INFORMATION		09/09/25	ZYL	DWJ	DC	SJL	
-	R01	ISSUED FOR INFORMATION		28/04/25	ZYL	DWJ	DC	SJL	
-	R00	ISSUED FOR INFORMATION (1 st GOE ISSUE)		27/12/24	ZYL	DWJ	DC	SJL	
Z0	-	ISSUED FOR AS-BUILT		28/09/22	JT	JT	NO	PL	
01	-	RE-ISSUED FOR CONSTRUCTION		28/12/20	XH	JT	NO	PL	
00	-	ISSUED FOR CONSTRUCTION		31/01/20	XH	JT	NO	PL	
C	-	ISSUED FOR DESIGN		07/11/19	XH	JT	NO	PL	
B	-	ISSUED FOR APPROVAL		06/03/19	BL	JT	NO	PL	
A	-	ISSUED FOR IDC		15/02/19	BL	JT	NO	PL	
GOE REV.	OTC REV.	REASON FOR USE			DATE	DRAWN	ISSUED	CHECKED	APPROVED
DISCIPLINE:	SYSTEM NO:	AREA / MODULE:	MO NO:	PROJECT NO:	SCALE:	SIZE:			
MR	56	FHM	8706014	SC26-2A	N.T.S.	A3			
SUPPLIER:			PROJECT: Sakarya Gas Field Dev't Phase-2a						
			TITLE: P&ID - OIL DRAIN SYSTEM IN ENGINE ROOM (SHEET 3)						
CLIENT:			OTC DOC. NO: SC26-2A-GOE-FHM-MR-PID-105090						
			LEG DOC. NO: -						
			REF. DOC. NO: 0384-KEP-V-XB-56005.003						
			GOE REV. -						
			OTC REV. R02						
			SHEET 3 of 3						
This drawing contains proprietary information and may not be transferred, reproduced or used to construct any project other than it was issued for without the written consent of GOE or their Client.									

12345678