



A
B
C
D
E
F

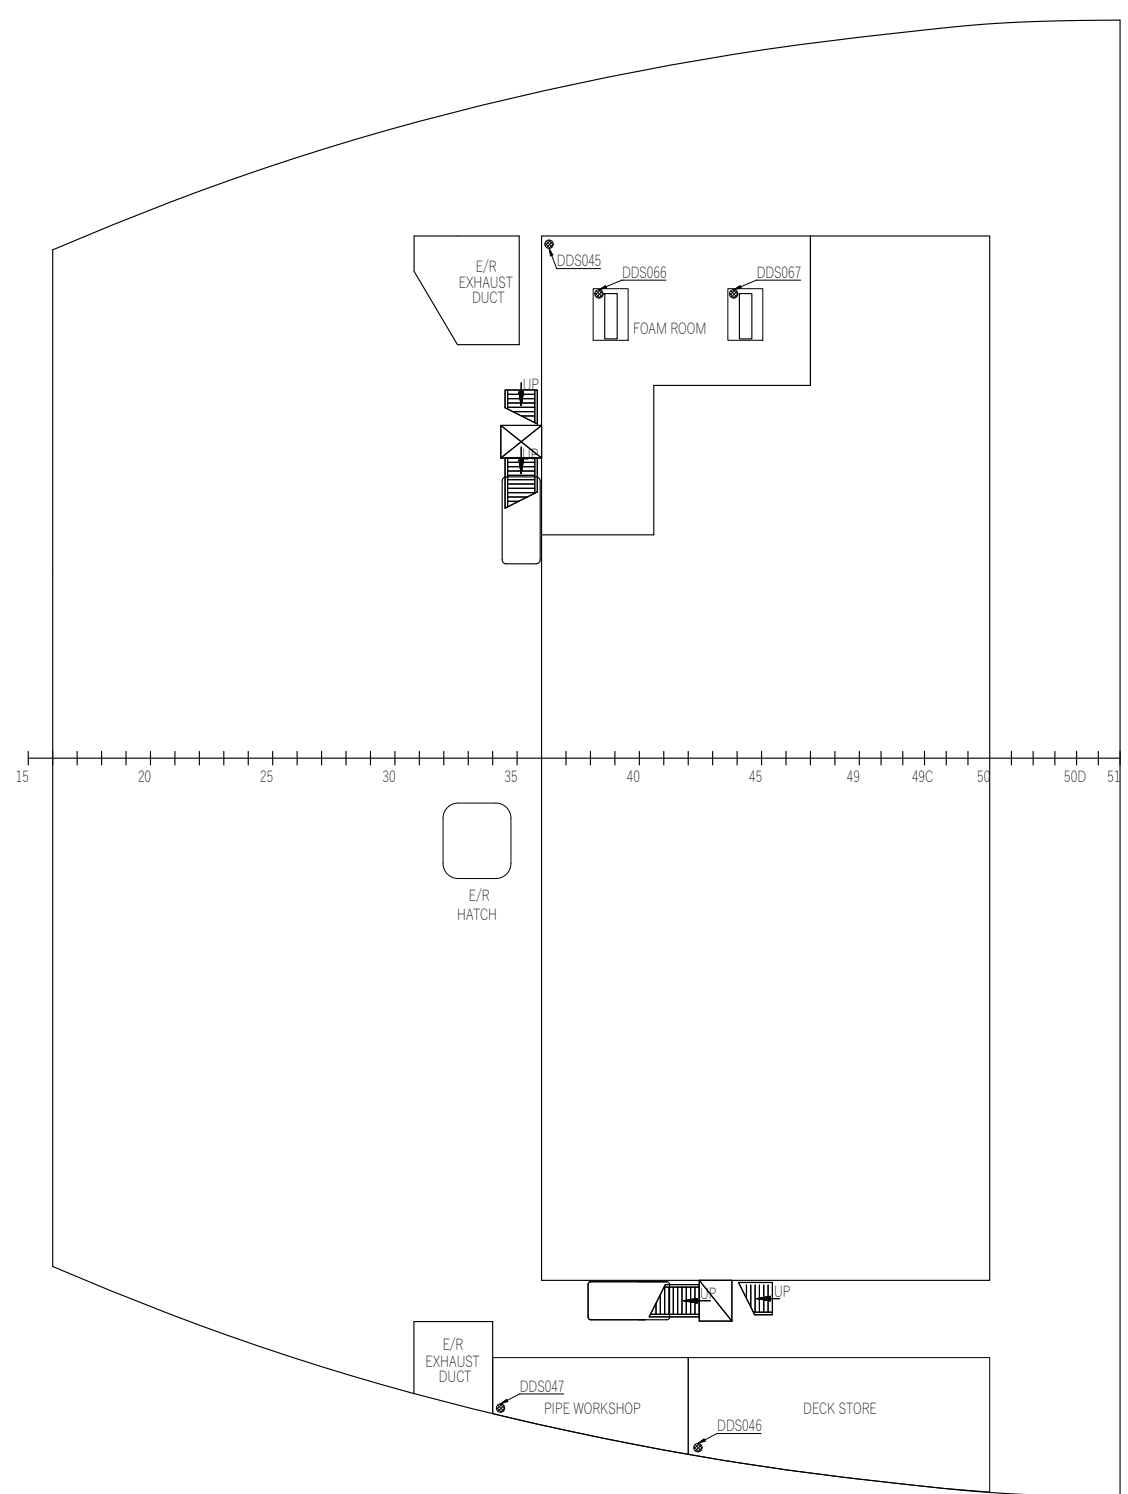

PLAN AT MAIN DECK

GENERAL NOTES:
1. THIS P&ID IS REISSUED FOR INFORMATION FOR SAKARYA PROJECT.
2. NO CHANGE IN SYSTEM.
3. SC26-2A-GOE-FHM-EP-SPC-105001 (0384-KEP-L-SA-00001) PIPING AND VALVE MATERIAL SPECIFICATION (MARINE SIDE).
4. SC26-2A-GOE-FHM-MR-PID-105133 TO 105139 P&ID SYMBOLS AND LEGEND (MARINE SIDE)
5. FOR CHANGES IN REV03, PLEASE REFER TO ECN-00377.

LEGEND:
● SCUPPER

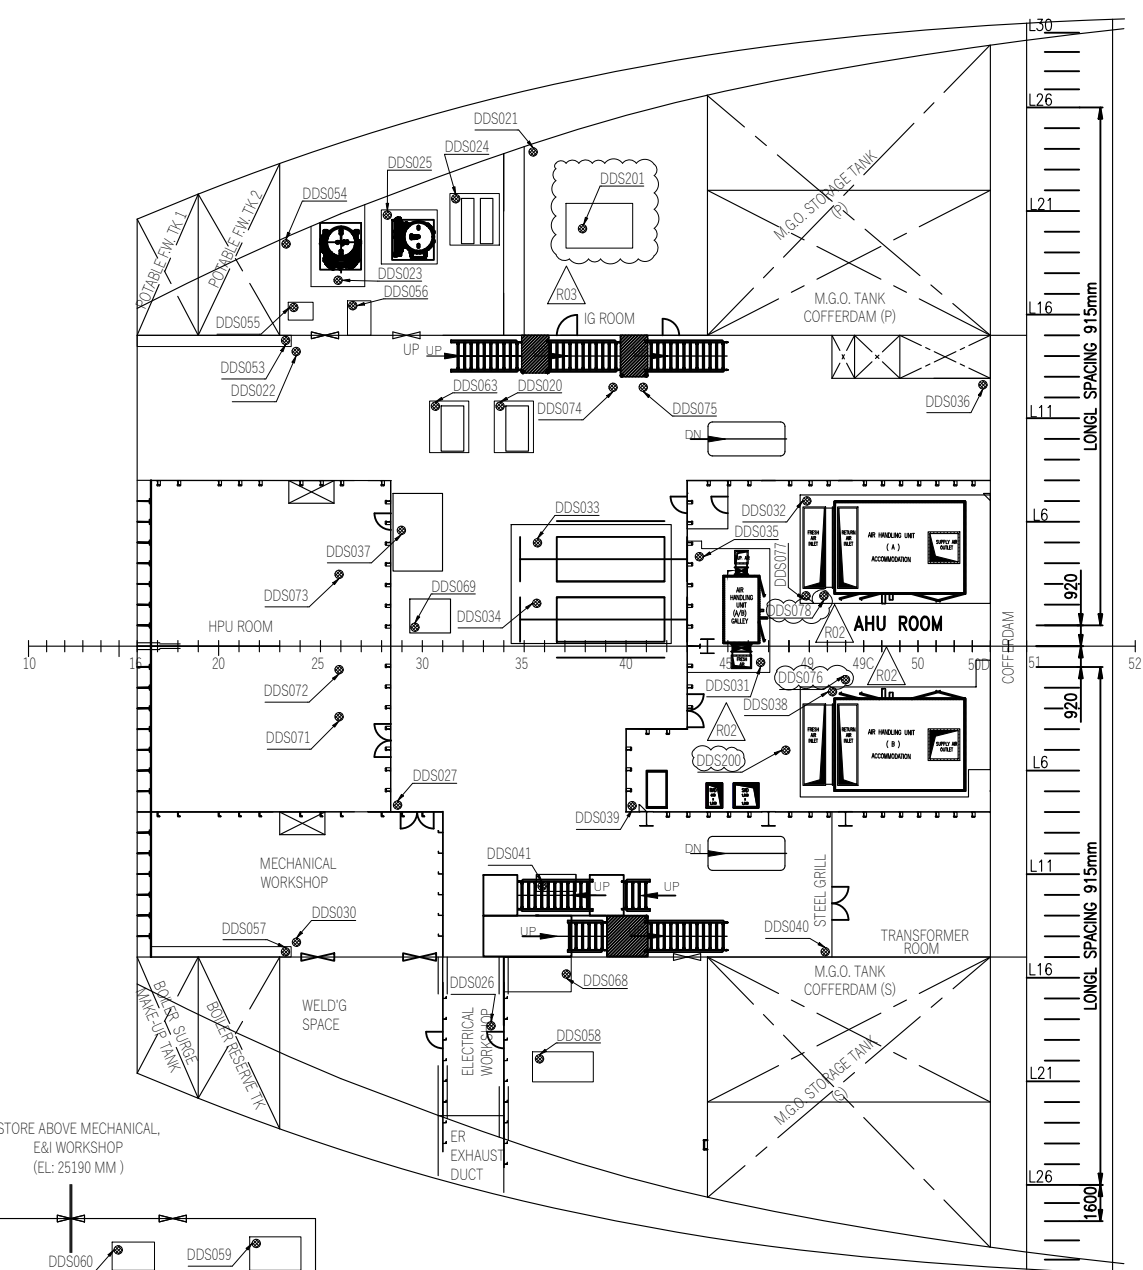

PLAN AT 1st PLATFORM DECK

-	R03	ISSUED FOR INFORMATION	13/03/26	ZYL	DWJ	DC	SJL	
-	R02	ISSUED FOR INFORMATION	09/09/25	ZYL	DWJ	DC	SJL	
-	R01	ISSUED FOR INFORMATION	28/04/25	ZYL	DWJ	DC	SJL	
-	R00	ISSUED FOR INFORMATION (1 st GOE ISSUE)	03/01/25	ZYL	DWJ	DC	SJL	
Z0	-	ISSUED FOR AS-BUILT	28/09/22	JT	JT	NO	PL	
02	-	RE-ISSUED FOR CONSTRUCTION	07/04/21	XH	JT	NO	PL	
01	-	RE-ISSUED FOR CONSTRUCTION	28/12/20	XH	JT	NO	PL	
00	-	ISSUED FOR CONSTRUCTION	31/01/20	XH	JT	NO	PL	
C	-	ISSUED FOR DESIGN	08/11/19	XH	JT	NO	PL	
B	-	ISSUED FOR APPROVAL	06/03/19	BL	JT	NO	PL	
A	-	ISSUED FOR IDC	15/02/19	BL	JT	NO	PL	
GOE REV	OTC REV	REASON FOR USE		DATE	DRAWN	ISSUED	CHECKED	APPROVED
DISCIPLINE:		SYSTEM NO.	AREA / MODULE:	IMO NO.	PROJECT NO.	SCALE:	SIZE:	
MR		56	FHM	8706014	SC26-2A	N.T.S.	A3	
SUPPLIER:			PROJECT: Sakarya Gas Field Dev't Phase-2a					
 OceanSTAR Elite			TITLE: P&ID - ENGINE ROOM DECK DRAIN SYSTEM (SHEET 3)					
CLIENT:			OTC DOC. NO. SC26-2A-GOE-FHM-MR-PID-105093				GOE REV. -	SHEET
 OTC OFFSHORE TECHNOLOGY CENTER			LEG DOC. NO. -				OTC REV.	3 of 4
			REF. DOC. NO. 0384-KEP-V-XB-56006.003					
This drawing contains proprietary information and may not be transferred, reproduced or used to construct any project other than it was issued for without the written consent of GOE or their Client.								

A
B
C
D
E
F