
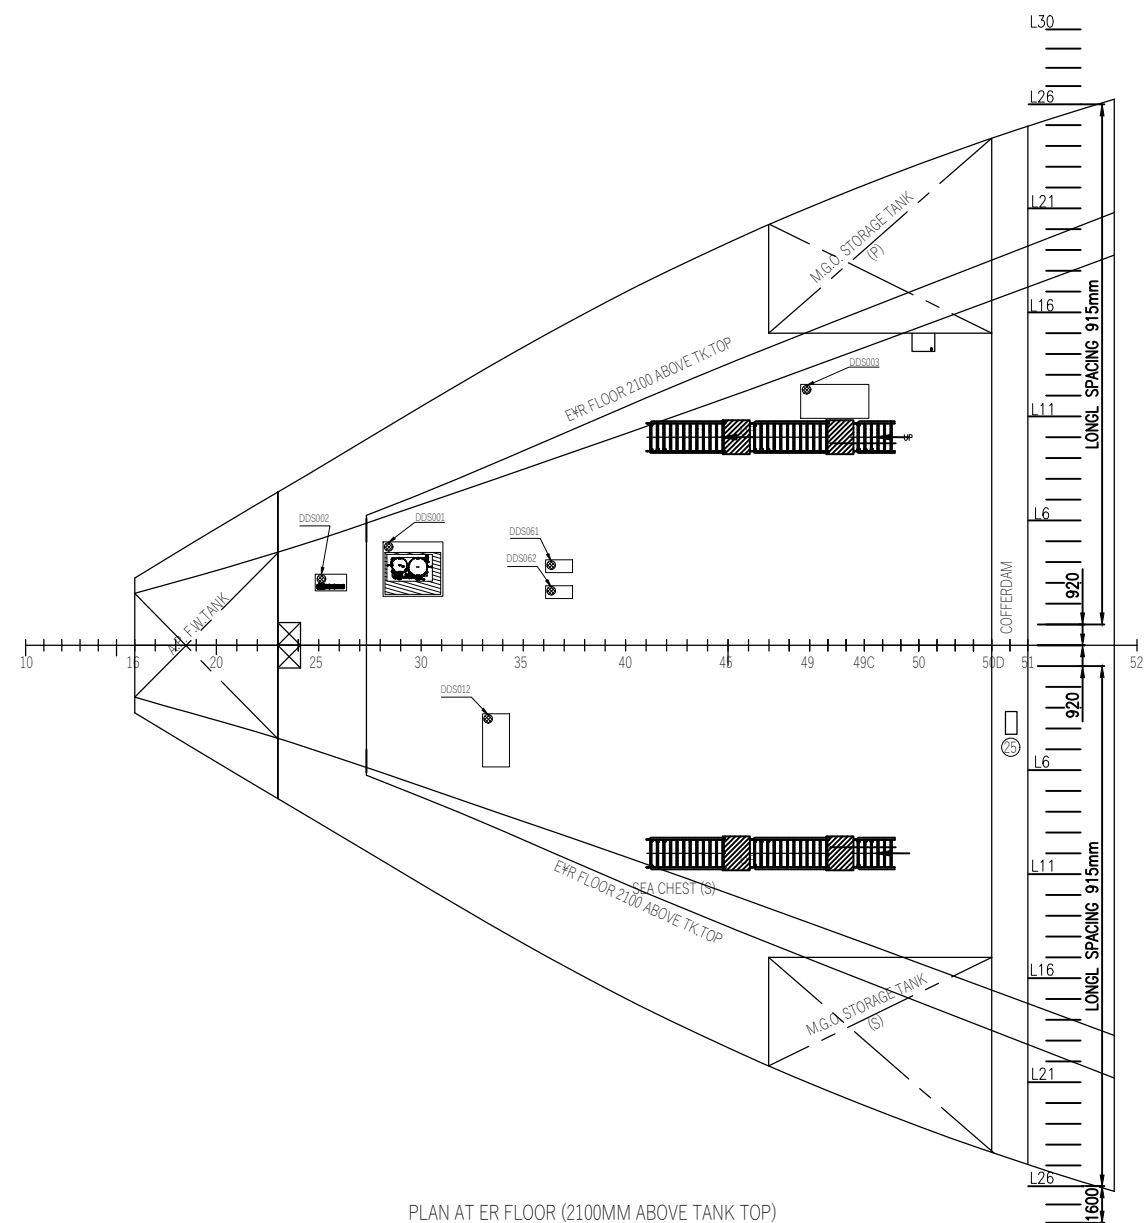
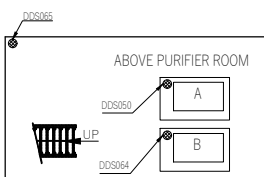


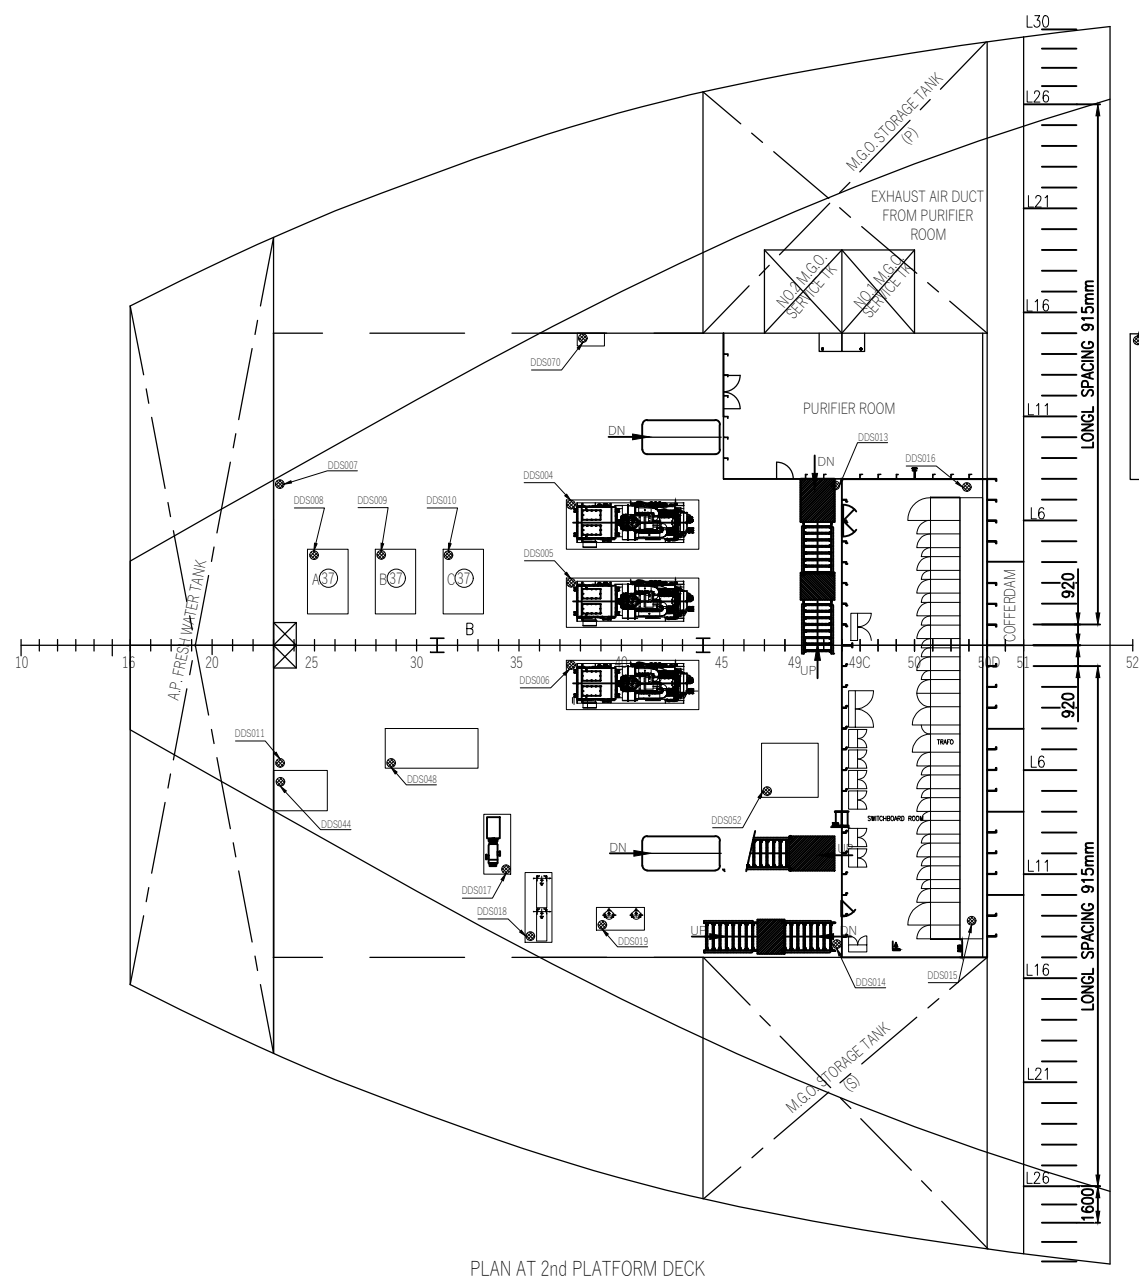

GENERAL NOTES:

1. THIS P&ID IS REISSUED FOR INFORMATION FOR SAKARYA PROJECT.
2. NO CHANGE IN SYSTEM.
3. FOR P&ID LEGEND SHEET SEE DRAWING:
SC26-2A-GOE-FGN-PE-PID-100018, SC26-2A-GOE-FGN-PE-PID-100021 TO 100031.
4. FOR MARINE PIPING AND VALVE MATERIAL SPECIFICATION, SEE DOCUMENT:
SC26-2A-GOE-FHM-EP-SPC-105001 (4517-BWO-L-SA-00002).

LEGEND:

● SCUPPER

-	R02	ISSUED FOR INFORMATION	09/09/25	ZYL	DWJ	DC	SJL
-	R01	ISSUED FOR INFORMATION	28/04/25	ZYL	DWJ	DC	SJL
-	R00	ISSUED FOR INFORMATION (1 st GOE ISSUE)	03/01/25	ZYL	DWJ	DC	SJL
Z0	-	ISSUED FOR AS-BUILT	28/09/22	JT	JT	NO	PL
02	-	RE-ISSUED FOR CONSTRUCTION	07/04/21	XH	JT	NO	PL
01	-	RE-ISSUED FOR CONSTRUCTION	28/12/20	XH	JT	NO	PL
00	-	ISSUED FOR CONSTRUCTION	31/01/20	XH	JT	NO	PL
C	-	ISSUED FOR DESIGN	08/11/19	XH	JT	NO	PL
B	-	ISSUED FOR APPROVAL	06/03/19	BL	JT	NO	PL
A	-	ISSUED FOR IDC	15/02/19	BL	JT	NO	PL
GOE REQ	OTC REQ	REASON FOR USE	DATE	DRAWN	ISSUED	CHECKED	APPROVED