


DAMPER LIST OUTSIDE OF LQ							
MANIFOLD LOCATION	GROUP	3-WAY VALVE (1/2")		DESCRIPTION	MODE	DAMPER TAGS	
		VALVE A	VALVE B				
67SP5505 2ND PLATFORM DECK (PORT)	2PDP1	67BAV5650	67BAV5651	FRESH AIR DUCT - PURIFIER ROOM	FIRE & GAS	97GE5638	
			67BAV5652	EXHAUST AIR DUCT - PURIFIER ROOM	FIRE & GAS	97GE5639	
			DELETED	DELETED	DELETED	DELETED	
	2PDS2	N/A	67BAV5678	SUPPLY AIR OUTLET - HVAC UNIT A - SWBD ROOM	SHUT OFF	97GE5625	
			67BAV5679	MIXED AIR INLET - HVAC UNIT A - SWBD ROOM	SHUT OFF	97GE5627	
			67BAV5680	SUPPLY AIR OUTLET - HVAC UNIT B - SWBD ROOM	SHUT OFF	97GE5626	
67BAV5681			MIXED AIR INLET - HVAC UNIT B - SWBD ROOM	SHUT OFF	97GE5628		
67SP5506 2ND PLATFORM DECK (STBD)	2PDS1	67BAV5674	67BAV5675	SUPPLY AIR DUCT - SWBD ROOM	FIRE & GAS	97GE5623	
			67BAV5676	RETURN AIR DUCT - SWBD ROOM	FIRE & GAS	97GE5624	
			67BAV5677	PRESSURE RELIEF DUCT - SWBD ROOM	FIRE & GAS	97GE5622	
67SP5507 1ST PLATFORM DECK (PORT)	1PDP1	67BAV5682	67BAV5683	NATURAL EXHAUST AIR DUCT - HPU ROOM	FIRE & GAS	97GE5642	
			67BAV5684	SUPPLY AIR DUCT - HPU ROOM (PORT)	FIRE & GAS	97GE5641	
			67BAV5673	NATURAL EXHAUST AIR DUCT - HPU ROOM	FIRE & GAS	97GE5650	
67SP5508 1ST PLATFORM DECK (STBD)	1PDS1	67BAV5691	67BAV5692	EXHAUST AIR DUCT - WELDING AREA	FIRE & GAS	97GE5621	
	1PDS2	67BAV5693	67BAV5694	FRESH AIR DUCT RISER - GALLEY AHU	FIRE & GAS	97GE5611	
			67BAV5704	FRESH AIR DUCT RISER - ACCOMMODATION AHU	FIRE & GAS	97GE5543	
			67BAV5705	PRESSURE RELIEF DUCT - AHU ROOM	FIRE & GAS	97GE5612	
	1PDS3	N/A	67BAV5706	SUPPLY AIR OUTLET - AHU A ACCOMMODATION	SHUT OFF	97GE5545	
			67BAV5707	MIXED AIR INLET - AHU A ACCOMMODATION	SHUT OFF	97GE5546	
	1PDS5	N/A	67BAV5708	SUPPLY AIR OUTLET - AHU B ACCOMMODATION	SHUT OFF	97GE5547	
			67BAV5709	MIXED AIR INLET - AHU B ACCOMMODATION	SHUT OFF	97GE5548	
	1PDS4	N/A	67BAV5710	SUPPLY AIR OUTLET - AHU A GALLEY	SHUT OFF	97GE5549	
			67BAV5711	FRESH AIR INLET - AHU A GALLEY	SHUT OFF	97GE5550	
			67BAV5712	SUPPLY AIR OUTLET - AHU B GALLEY	SHUT OFF	97GE5551	
			67BAV5713	FRESH AIR INLET - AHU B GALLEY	SHUT OFF	97GE5552	
	67SP5509 MAIN DECK (PORT)	MDP1	67BAV5714	67BAV5715	FRESH AIR DUCT - FOAM ROOM	FIRE & GAS	97GE5522
				67BAV5716	EXHAUST AIR DUCT - FOAM ROOM	FIRE & GAS	97GE5523
		MDP2	67BAV5717	67BAV5718	EXHAUST AIR DUCT - FIRE LOCKER	FIRE & GAS	97GE5526
67BAV5725				SUPPLY AIR DUCT - FIRE LOCKER	FIRE & GAS	97GE5527	
MDP3		67BAV5726	67BAV5727	FRESH AIR DUCT - OXYGEN AND ACETYLENE ROOM	FIRE & GAS	97GE5530	
			67BAV5728	FRESH AIR DUCT - OXYGEN AND ACETYLENE ROOM	FIRE & GAS	97GE5531	
			67BAV5735	EXHAUST AIR DUCT - OXYGEN AND ACETYLENE ROOM	FIRE & GAS	97GE5532	
			67BAV5736	EXHAUST AIR DUCT - OXYGEN AND ACETYLENE ROOM	FIRE & GAS	97GE5533	
67SP5510 MAIN DECK (STBD)		MDS1	67BAV5737	67BAV5738	EXHAUST AIR DUCT - PAINT STORE	FIRE & GAS	97GE5538
	67BAV5739			FRESH AIR DUCT - PAINT STORE	FIRE & GAS	97GE5539	
	MDS2			67BAV5740	67BAV5748	EXHAUST AIR DUCT - SMOKING ROOM	FIRE & GAS
		67BAV5749	SUPPLY AIR DUCT - SMOKING ROOM		FIRE & GAS	97GE5541	
	MDS3	67BAV5750	67BAV5758	EXHAUST AIR DUCT - LABORATORY	FIRE & GAS	97GE5508	
			67BAV5759	FRESH AIR DUCT - LABORATORY	FIRE & GAS	97GE5509	
	MDS4	67BAV5760	67BAV5761	EXHAUST AIR DUCT - DECK STORE	FIRE & GAS	97GE5613	
			67BAV5762	FRESH AIR DUCT - DECK STORE	FIRE & GAS	97GE5614	
			MDS5	67BAV5763	67BAV5764	EXHAUST AIR DUCT - PIPE WORKSHOP	FIRE & GAS
	67BAV5767	FRESH AIR DUCT - PIPE WORKSHOP			FIRE & GAS	97GE5616	
67SP5511 POOP DECK (PORT)	1PPDP1	67BAV5768	67BAV5769	FRESH AIR DUCT - EMERGENCY GENERATOR ROOM (NORMAL & EMERGENCY)	FIRE & GAS	97GE5617	
			67BAV5770	FRESH AIR INTAKE - EMERGENCY GENERATOR ROOM (EMERGENCY)	FIRE & GAS	97GE5619	
	1PPDP6	67BAV5773	67BAV5774	EXHAUST AIR DUCT - EMERGENCY GENERATOR ROOM (NORMAL & EMERGENCY)	FIRE & GAS	97GE5618	
			67BAV5775	RADIATOR EXHAUST AIR OUTLET - EMERGENCY GENERATOR ROOM	FIRE & GAS	97GE5620	
	1PPDP2	67BAV5776	67BAV5796	FRESH AIR DUCT - VENTILATION FAN A (AFT. PORT)	FIRE & GAS	97GE5629	
			67BAV5799	FRESH AIR DUCT - VENTILATION FAN C (FWD. PORT)	FIRE & GAS	97GE5630	
	1PPDP4	67BAV5800	67BAV5809	FRESH AIR DUCT - VENTILATION FAN B (AFT. STBD)	FIRE & GAS	97GE5631	
			67BAV5810	FRESH AIR DUCT - VENTILATION FAN D (FWD. STBD)	FIRE & GAS	97GE5632	
	1PPDP3	67BAV5811	67BAV5812	NATURAL EXHAUST AIR OUTLET (OUTBOARD PORT)	FIRE & GAS	97GE5633	
			67BAV5820	NATURAL EXHAUST AIR OUTLET (FUNNEL TOP PORT)	FIRE & GAS	97GE5635	
1PPDP5	67BAV5814	67BAV5813	NATURAL EXHAUST AIR OUTLET (AFT. PORT)	FIRE & GAS	97GE5634		
67SP5512 POOP DECK (STBD)	1PPDS1	67BAV5821	67BAV5822	SUPPLY AIR DUCT - SECONDARY FIRE LOCKER	FIRE & GAS	97GE5571	
			67BAV5837	EXHAUST AIR DUCT - SECONDARY FIRE LOCKER	FIRE & GAS	97GE5572	
	1PPDS2	67BAV5838	67BAV5839	SUPPLY AIR DUCT - SECONDARY CONTROL ROOM	FIRE & GAS	97GE5578	
			67BAV5840	RETURN AIR DUCT - SECONDARY CONTROL ROOM	FIRE & GAS	97GE5579	
	1PPDS3	67BAV5841	67BAV5842	SUPPLY AIR DUCT - BATTERY ROOM B	FIRE & GAS	97GE5512	
			67BAV5843	EXHAUST AIR DUCT - BATTERY ROOM B	FIRE & GAS	97GE5513	
			67BAV5844	SUPPLY AIR OUTLET - HVAC UNIT A - BATTERY ROOM B	SHUT OFF	97GE5518	
	1PPDS4	N/A	67BAV5845	FRESH AIR INLET - HVAC UNIT A - BATTERY ROOM B	SHUT OFF	97GE5520	
			67BAV5846	SUPPLY AIR OUTLET - HVAC UNIT B - BATTERY ROOM B	SHUT OFF	97GE5519	
			67BAV5847	FRESH AIR INLET - HVAC UNIT B - BATTERY ROOM B	SHUT OFF	97GE5521	
			1PPDS5	67BAV5848	67BAV5849	NATURAL EXHAUST AIR OUTLET (FWD. STBD)	FIRE & GAS
	1PPDS6	67BAV5690	67BAV5850	NATURAL EXHAUST AIR OUTLET (AFT. STBD)	FIRE & GAS	97GE5637	

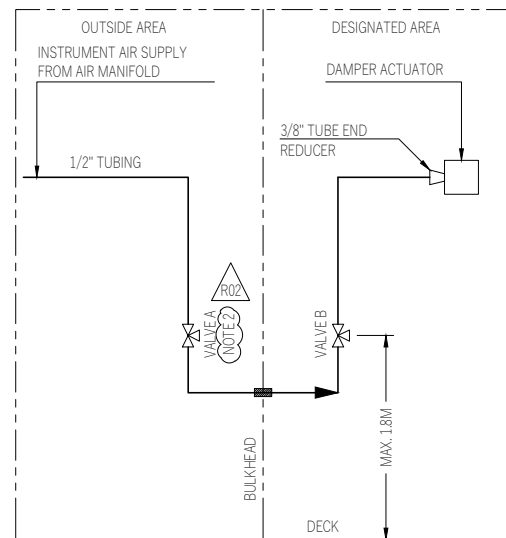

GENERAL NOTES:


1. THIS P&ID IS REISSUED FOR INFORMATION FOR SAKARYA PROJECT.
2. NO CHANGE IN SYSTEM.
3. FOR P&ID LEGEND SHEET SEE DRAWING:
SC26-2A-GOE-FGN-PE-PID-100018, SC26-2A-GOE-FGN-PE-PID-100021 TO 100031.
4. FOR MARINE PIPING AND VALVE MATERIAL SPECIFICATION, SEE DOCUMENT:
SC26-2A-GOE-FHM-EP-SPC15001 (4517-BWO-L-SA-00002).

NOTES:

1. REFER TO INSTRUMENT HOOK UP DRAWING 0384-KEP-I-XQ-00001.
(2. TO KEEP OPEN FOR ALL VALVES OF F&G DAMPERS.)

LEGENDS:

————— EXISTING PIPE

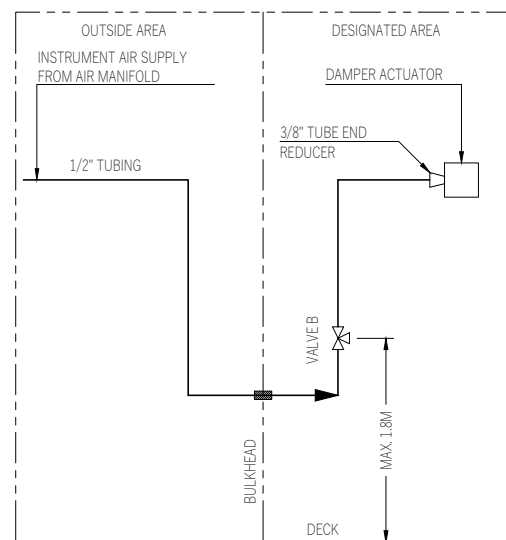

-	R02	ISSUED FOR INFORMATION	11/09/25	ZYL	DWJ	DC	SJL
-	R01	ISSUED FOR INFORMATION	27/04/25	ZYL	DWJ	DC	SJL
-	R00	ISSUED FOR INFORMATION(1 st GOE ISSUE)	07/01/25	ZYL	DWJ	DC	SJL
Z1	-	RE-ISSUED FOR AS-BUILT	26/01/23	EM	ADB	NO	PL
Z0	-	ISSUED FOR AS-BUILT	28/09/22	JT	JT	NO	PL
02	-	RE-ISSUED FOR CONSTRUCTION	08/04/21	TXH	JT	NO	PL
01	-	RE-ISSUED FOR CONSTRUCTION	05/11/20	TXH	JT	NO	PL
00	-	ISSUED FOR CONSTRUCTION	31/03/20	TXH	JT	NO	PL
C	-	ISSUED FOR DESIGN	22/05/19	ADB	JT	NO	PL
B	-	ISSUED FOR REVIEW	09/05/19	ADB	JT	NO	PL
A	-	ISSUED FOR IDC	19/03/19	ADB	JT	NO	PL
GOE REV	OTC REV	REASON FOR USE	DATE	DRAWN	ISSUED	CHECKED	APPROVED

DISCIPLINE: MR	SYSTEM NO: 67	AREA / MODULE: FHM	IMO NO: 8706014	PROJECT NO: SC26-2A	SCALE: N.T.S.	SIZE: A3
SUPPLIER:  OceanSTAR Elite			PROJECT: Sakarya Gas Field Dev't Phase-2a			
 GLOBAL OFFSHORE ENGINEERING			TITLE: P&ID - INSTRUMENT AIR DISTRIBUTION SYSTEM IN FHM ROOM (SHEET 3)			
CLIENT:  OTC OFFSHORE TECHNOLOGY CENTER			OTC DOC. NO: SC26-2A-GOE-FHM-MR-PID-105112 LEG. DOC. NO: - REF. DOC. NO: 0384-KEP-V-XB-67003.004		GOE REV. - OTC REV. R02	SHEET 3 of 3