

EQUIP. TAG	67VL5504
EQUIP. NAME	EMERGENCY AIR RECEIVER FOR QCV
CAPACITY	0.1 m3
CONFIGURATION	1 x 100%
OPERATING (DESIGN) PRESSURE	10 (11) BARG
OPERATING (DESIGN) TEMP.	°C

67VL5504 INTERFACE		
TP	DESCRIPTION	CONNECTION TYPE / SIZE
N1	AIR INLET	1"
N2	AIR OUTLET	1"
N3	DRAIN	1"
N4	PSV OUTLET	3/4"
N5	PIT CONNECTION	2"

A

B


C

D

E

F

FROM INSTRUMENT
AIR DISTRIBUTION
GOE-FHM-MR-PID-105110
0384-KEP-V-XB-67003.002

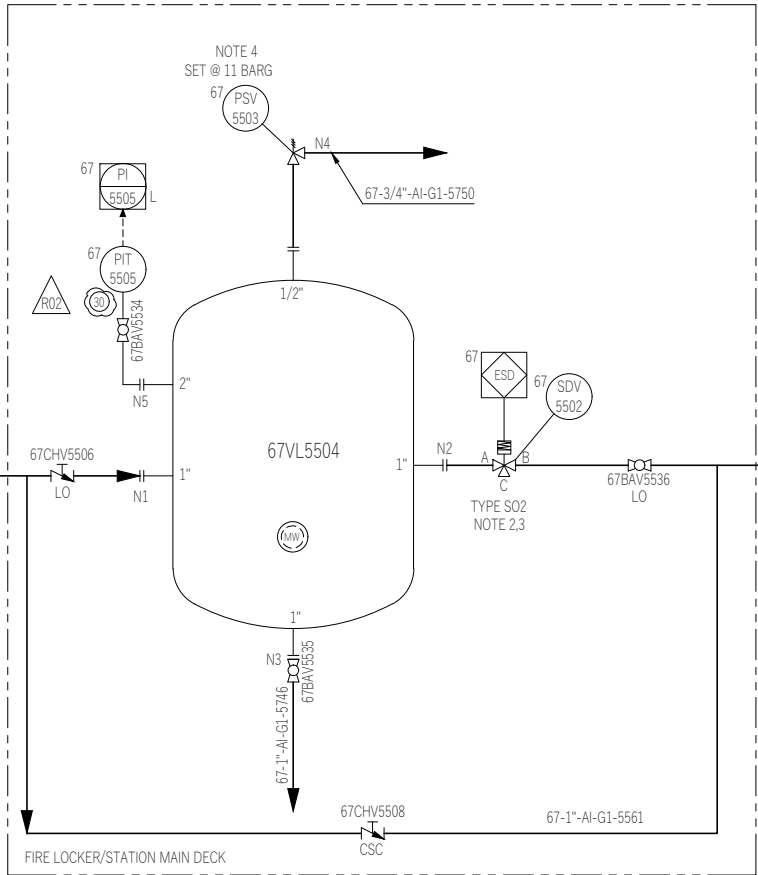

SYSTEM PARAMETERS	
SERVICE	INSTRUMENT AIR
DESIGN PRESSURE(Barg)	11.5
OPERATING PRESSURE(Barg)	10.0
DESIGN TEMPERATURE(°C)	50.0
OPERATING TEMPERATURE(°C)	AMB

GENERAL NOTES:

1. THIS P&ID IS REISSUED FOR INFORMATION FOR SAKARYA PROJECT.
2. NO CHANGE IN SYSTEM.
3. FOR P&ID LEGEND SHEET SEE DRAWING:
SC26-2A-GOE-FGN-PE-PID-100018, SC26-2A-GOE-FGN-PE-PID-100021 TO 100031.
4. FOR MARINE PIPING AND VALVE MATERIAL SPECIFICATION, SEE DOCUMENT:
SC26-2A-GOE-FHM-EP-SPC-105001 (4517-BWO-L-SA-00002).

NOTES:

1. DRAIN AT LOWEST POINT
2. DURING NORMAL CONDITIONS, 67SDV5502 WILL BE AT POSITION "B" TO "C", UPON ESD 2.1 SIGNAL, VALVE POSITION WILL BE "A" TO "B" TO SUPPLY AIR TO QCVS. VALVE FAILURE POSITION WILL BE AT "A" TO "B".
3. VALVE TYPICAL DETAIL REFER TO P&ID SYMBOLS AND LEGEND.
4. VENDOR SUPPLY.

LEGENDS:

EXISTING PIPE

-	R02	ISSUED FOR INFORMATION	12/09/25	ZYL	DWJ	DC	SJL
-	R01	ISSUED FOR INFORMATION	14/05/25	ZYL	DWJ	DC	SJL
-	R00	ISSUED FOR INFORMATION (1 st GOE ISSUE)	09/01/25	ZYL	DWJ	DC	SJL
Z0	-	ISSUED FOR AS-BUILT	28/09/22	JT	JT	NO	PL
02	-	RE-ISSUED FOR CONSTRUCTION	07/04/21	XH	JT	NO	PL
01	-	RE-ISSUED FOR CONSTRUCTION	05/11/20	XH	JT	NO	PL
00	-	ISSUED FOR CONSTRUCTION	05/02/20	XH	JT	NO	PL
C	-	ISSUED FOR DESIGN	10/05/19	ADB	JT	NO	PL
B	-	ISSUED FOR REVIEW	29/03/19	ADB	JT	NO	PL
A	-	ISSUED FOR IDC	19/03/19	ADB	JT	NO	PL
GOE REV.	OTC REV.	REASON FOR USE	DATE	DRAWN	ISSUED	CHECKED	APPROVED

DISCIPLINE: MR	SYSTEM NO: 67	AREA / MODULE: FHM	MO NO: 8706014	PROJECT NO: SC26-2A	SCALE: N.T.S.	SIZE: A3
SUPPLIER:  OceenSTAR Elite		PROJECT: Sakarya Gas Field Dev't Phase-2a				
CLIENT:  OTC OFFSHORE TECHNOLOGY CENTER		TITLE: P&ID - INSTRUMENT AIR QUICK CLOSING VALVE SYSTEM IN NEW AFT HULL				
		OTC DOC. NO:	SC26-2A-GOE-FHM-MR-PID-105113	GOE REV.:	-	SHEET
		LEG DOC. NO:	-	OTC REV.:	R02	1 of 1
		REF. DOC. NO:	0384-KEP-V-XB-67005.001			

This drawing contains proprietary information and may not be transferred, reproduced or used to construct any project other than it was issued for without the written consent of GOE or their Client.

A

B

C

D

E

F

1

2

3

4

5

6

7

8