


EQUIP. TAG	69TG006A/B/C
EQUIP. NAME	T/A LUBE OIL SUMP TANK
CAPACITY	4 m3

NOTE: there is no lube oil line to any user (turbine, alternator, etc.). Only supply line and drain line. This was commented on R00 and is still not corrected.

The additional vendor PID do not have a oil filling connected to the system.

FROM NEW LUBE OIL
TRANSFER PUMP
GOE-FHM-MR-PID-105114
0384-KEP-V-XB-69001.001

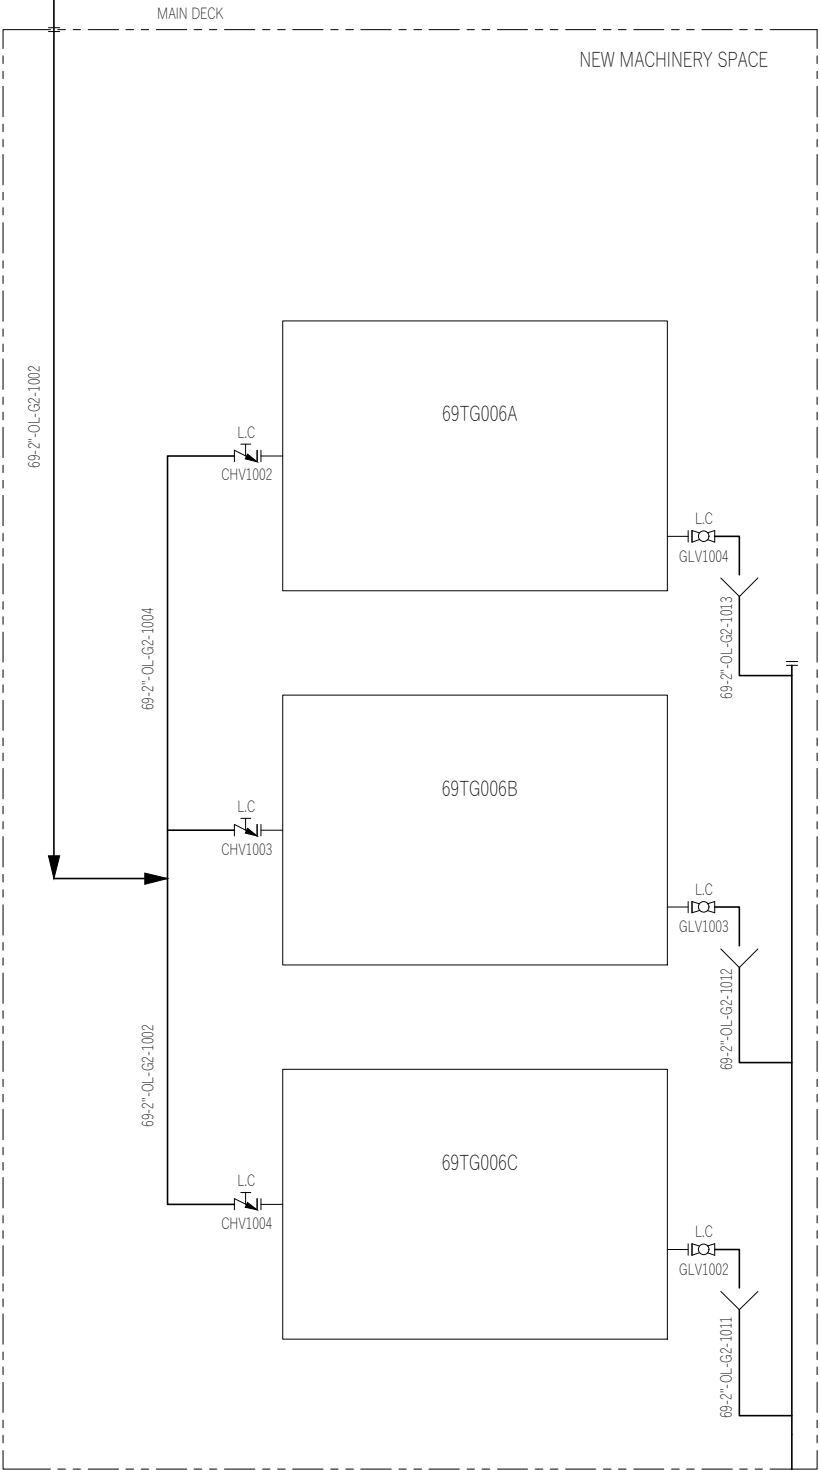

BILGE SYSTEM IN
NO.6 MACHINERY SPACE
GOE-FHM-MR-PID-105019
384-44-P-DWG-101_001

GENERAL NOTES:

1. ALL VALVE TAG NUMBERS ARE TO BE PRECEDED BY THE SYSTEM NUMBER 69, UNLESS OTHERWISE STATED.
2. THIS P&ID IS REISSUED FOR INFORMATION FOR SAKARYA PROJECT.
3. NO CHANGE IN SYSTEM.
4. FOR P&ID LEGEND SHEET SEE DRAWING:
SC26-2A-GOE-FGN-PE-PID-100018, SC26-2A-GOE-FGN-PE-PID-100021 TO 100031.
5. FOR MARINE PIPING AND VALVE MATERIAL SPECIFICATION SEE DOCUMENT:
SC26-2A-GOE-FHM-EP-SPC-105001 (4517-BWO-L-SA-00002).

NOTES:

1. FOR VENDOR STG P&ID AND PIPE ARRANGEMENT, REFER TO NEXT TWO PAGES.

HOLDS:

1. DELETED.

LEGENDS:


EXISTING PIPE

SYSTEM PARAMETERS		
SERVICE	LO SUPPLY	DRAIN
DESIGN PRESSURE(Barg)	4.0	3.5
OPERATING PRESSURE(Barg)	3.0	ATM
DESIGN TEMPERATURE(°C)	50.0	50.0
OPERATING TEMPERATURE(°C)	AMB	AMB

-	R02	ISSUED FOR INFORMATION		15/09/25	ZYL	DWJ	DC	SJL					
-	R01	ISSUED FOR INFORMATION		24/06/25	ZYL	DWJ	DC	SJL					
-	R00	ISSUED FOR INFORMATION (1 st GOE ISSUE)		23/12/24	ZYL	DWJ	DC	SJL					
Z	-	AS BUILT		09/03/09	YGL	NA	NA	NA					
4	-	REVISED AS MARKED		02/06/08	AILEEN	NA	NA	NA					
3	-	REISSUED FOR CONSTRUCTION		12/02/08	KAM	NA	NA	NA					
2	-	REISSUED FOR CONSTRUCTION		25/01/08	YGL	NA	NA	NA					
1	-	REISSUED FOR CONSTRUCTION		04/12/07	KAM	NA	NA	NA					
0	-	ISSUED FOR CONSTRUCTION		18/09/07	KAM	NA	NA	NA					
B	-	ISSUED FOR IDC		04/09/07	KAM	NA	NA	NA					
A	-	ISSUED FOR HAZOP		07/07/07	IRIS	NA	NA	NA					
GOE REV.	OTC REV.	REASON FOR USE			DATE	DRAWN	ISSUED	CHECKED	APPROVED				
DISCIPLINE:	MR	SYSTEM NO:	69	AREA / MODULE:	FHM	MO NO:	8706014	PROJECT NO:	SC26-2A	SCALE:	N.T.S.	SIZE:	A3
SUPPLIER:		 		PROJECT: Sakarya Gas Field Dev't Phase-2a									
CLIENT:				TITLE: P&ID - LUBRICATION OIL SYSTEM IN 6MS									
  OFFSHORE TECHNOLOGY CENTER		OTC DOC. NO: SC26-2A-GOE-FHM-MR-PID-105115						GOE REV. -		SHEET 1 of 1			
		LEG DOC. NO: -						OTC REV. R02					
		REF. DOC. NO: 384-69-P-DWG-101_001											
This drawing contains proprietary information and may not be transferred, reproduced or used to construct any project other than it was issued for without the written consent of GOE or their Client.													

REVISION:
Rev1 : 2007-9-12
Rev2 : 2008-2-1

OIL TANK UNIT

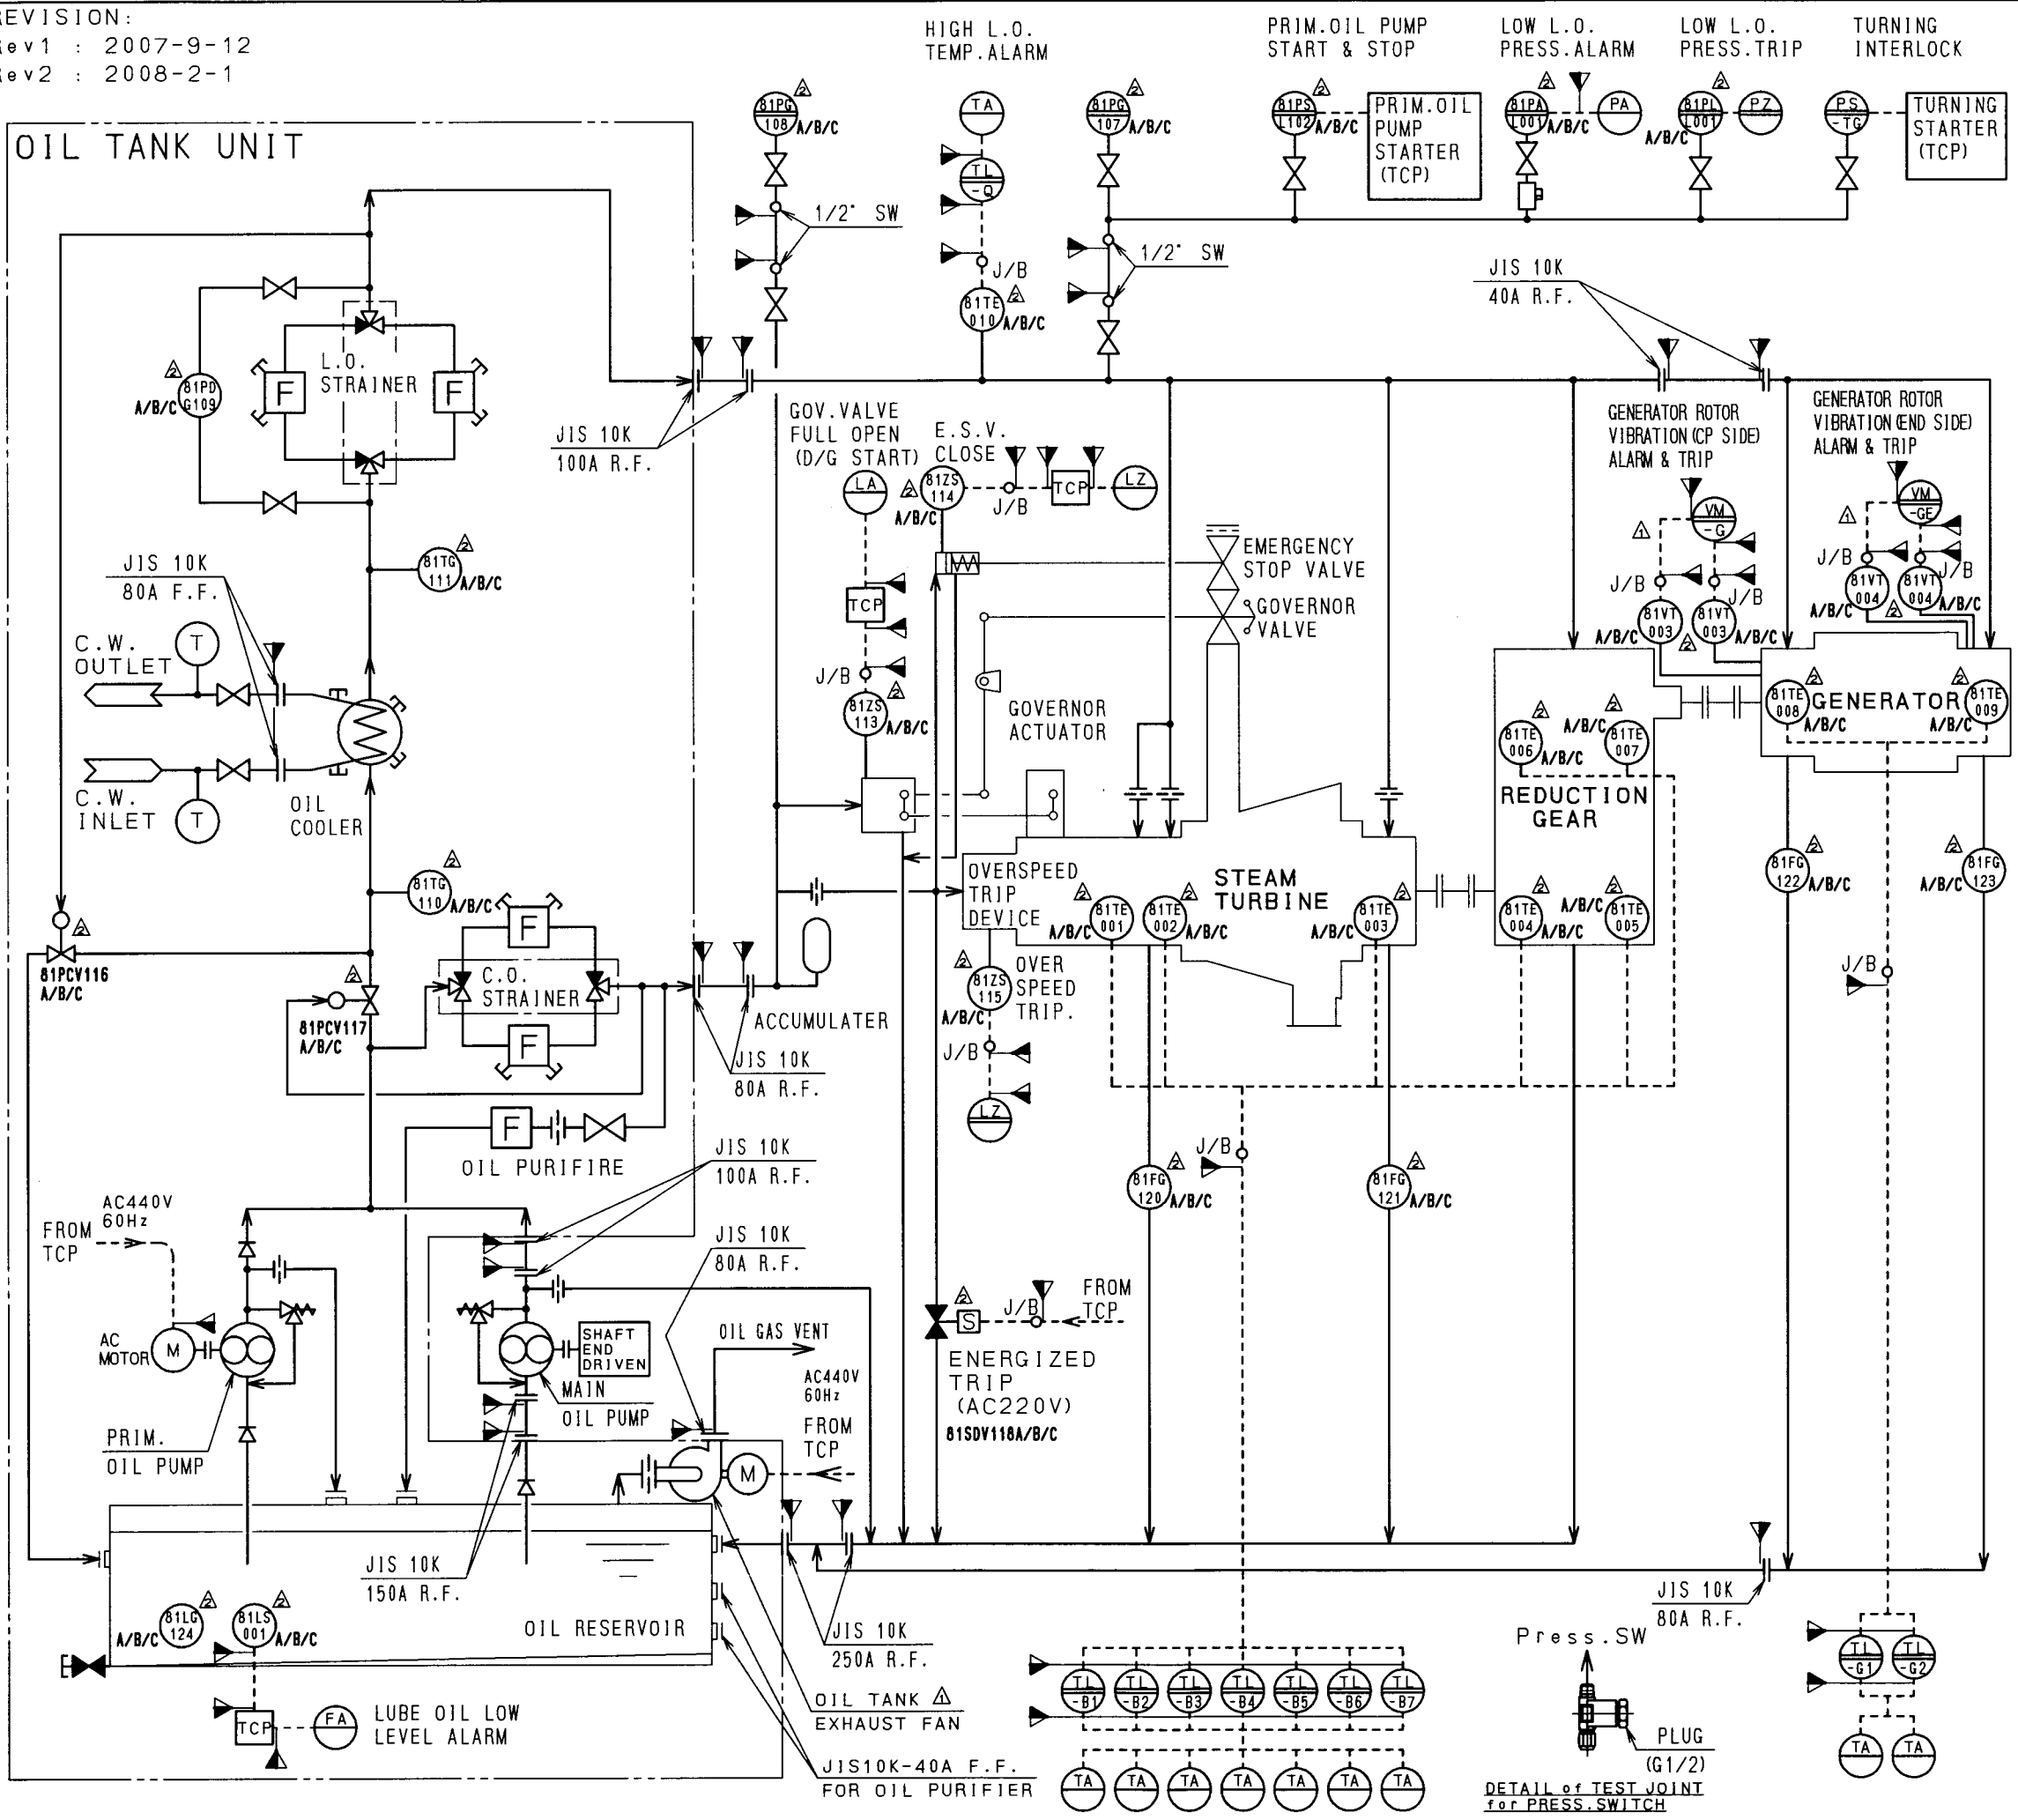

SYMBOL	DESCRIPTION
	NORMAL OPEN VALVE
	NORMAL CLOSE VALVE
	CHECK VALVE
	PLUG
	COCK
	STRAINER
	SAFETY VALVE
	PRESSURE REGULATING VALVE
	ORIFICE
	SOLENOID VALVE
	LOCALLY MOUNTED
	REMOTE (PURCHASER)
	TURBINE CONTROL PANEL
	81PG PRESSURE GAUGE
	81PDG DUPLEX PRESS. GAUGE
	PS PRESSURE SWITCH
	81PS PRESSURE SWITCH
	81PA/81PL PRESSURE SWITCH ALARM/TRIP
	81TE THERMO-SENSOR
	TL TEMPERATURE INDICATOR
	T THERMOMETER
	81TG THERMOMETER
	81VT GENE. VIBRATION SENSOR
	VM-G GENE. VIBRATION MONITOR (CP SIDE)
	VM-GE GENE. VIBRATION MONITOR (END SIDE)
	81LG LEVEL GAUGE
	81LS FLOAT SWITCH
	81FG SIGHT FLOW
	81ZS LIMIT SWITCH
	*A / *Z ALARM / TRIP
	M MOTOR
	J/B JUNCTION BOX
	PROCESS PIPING
	ELECTRIC WIRING
	TEST JOINT

SUPPLY LIMIT

PURCHASER SHINKO

ITEM NO.	FPSO Cidade de São Mateus
ORDER NO.	P0001621
OIL FLOW AND INSTRUMENTATION DIAGRAM OF STEAM TURBINE	
MODEL	DNG115-75
DRAW.NO.	TH12007
REV.	2

SHINKO IND.LTD.

TH12007-P1621R2

