


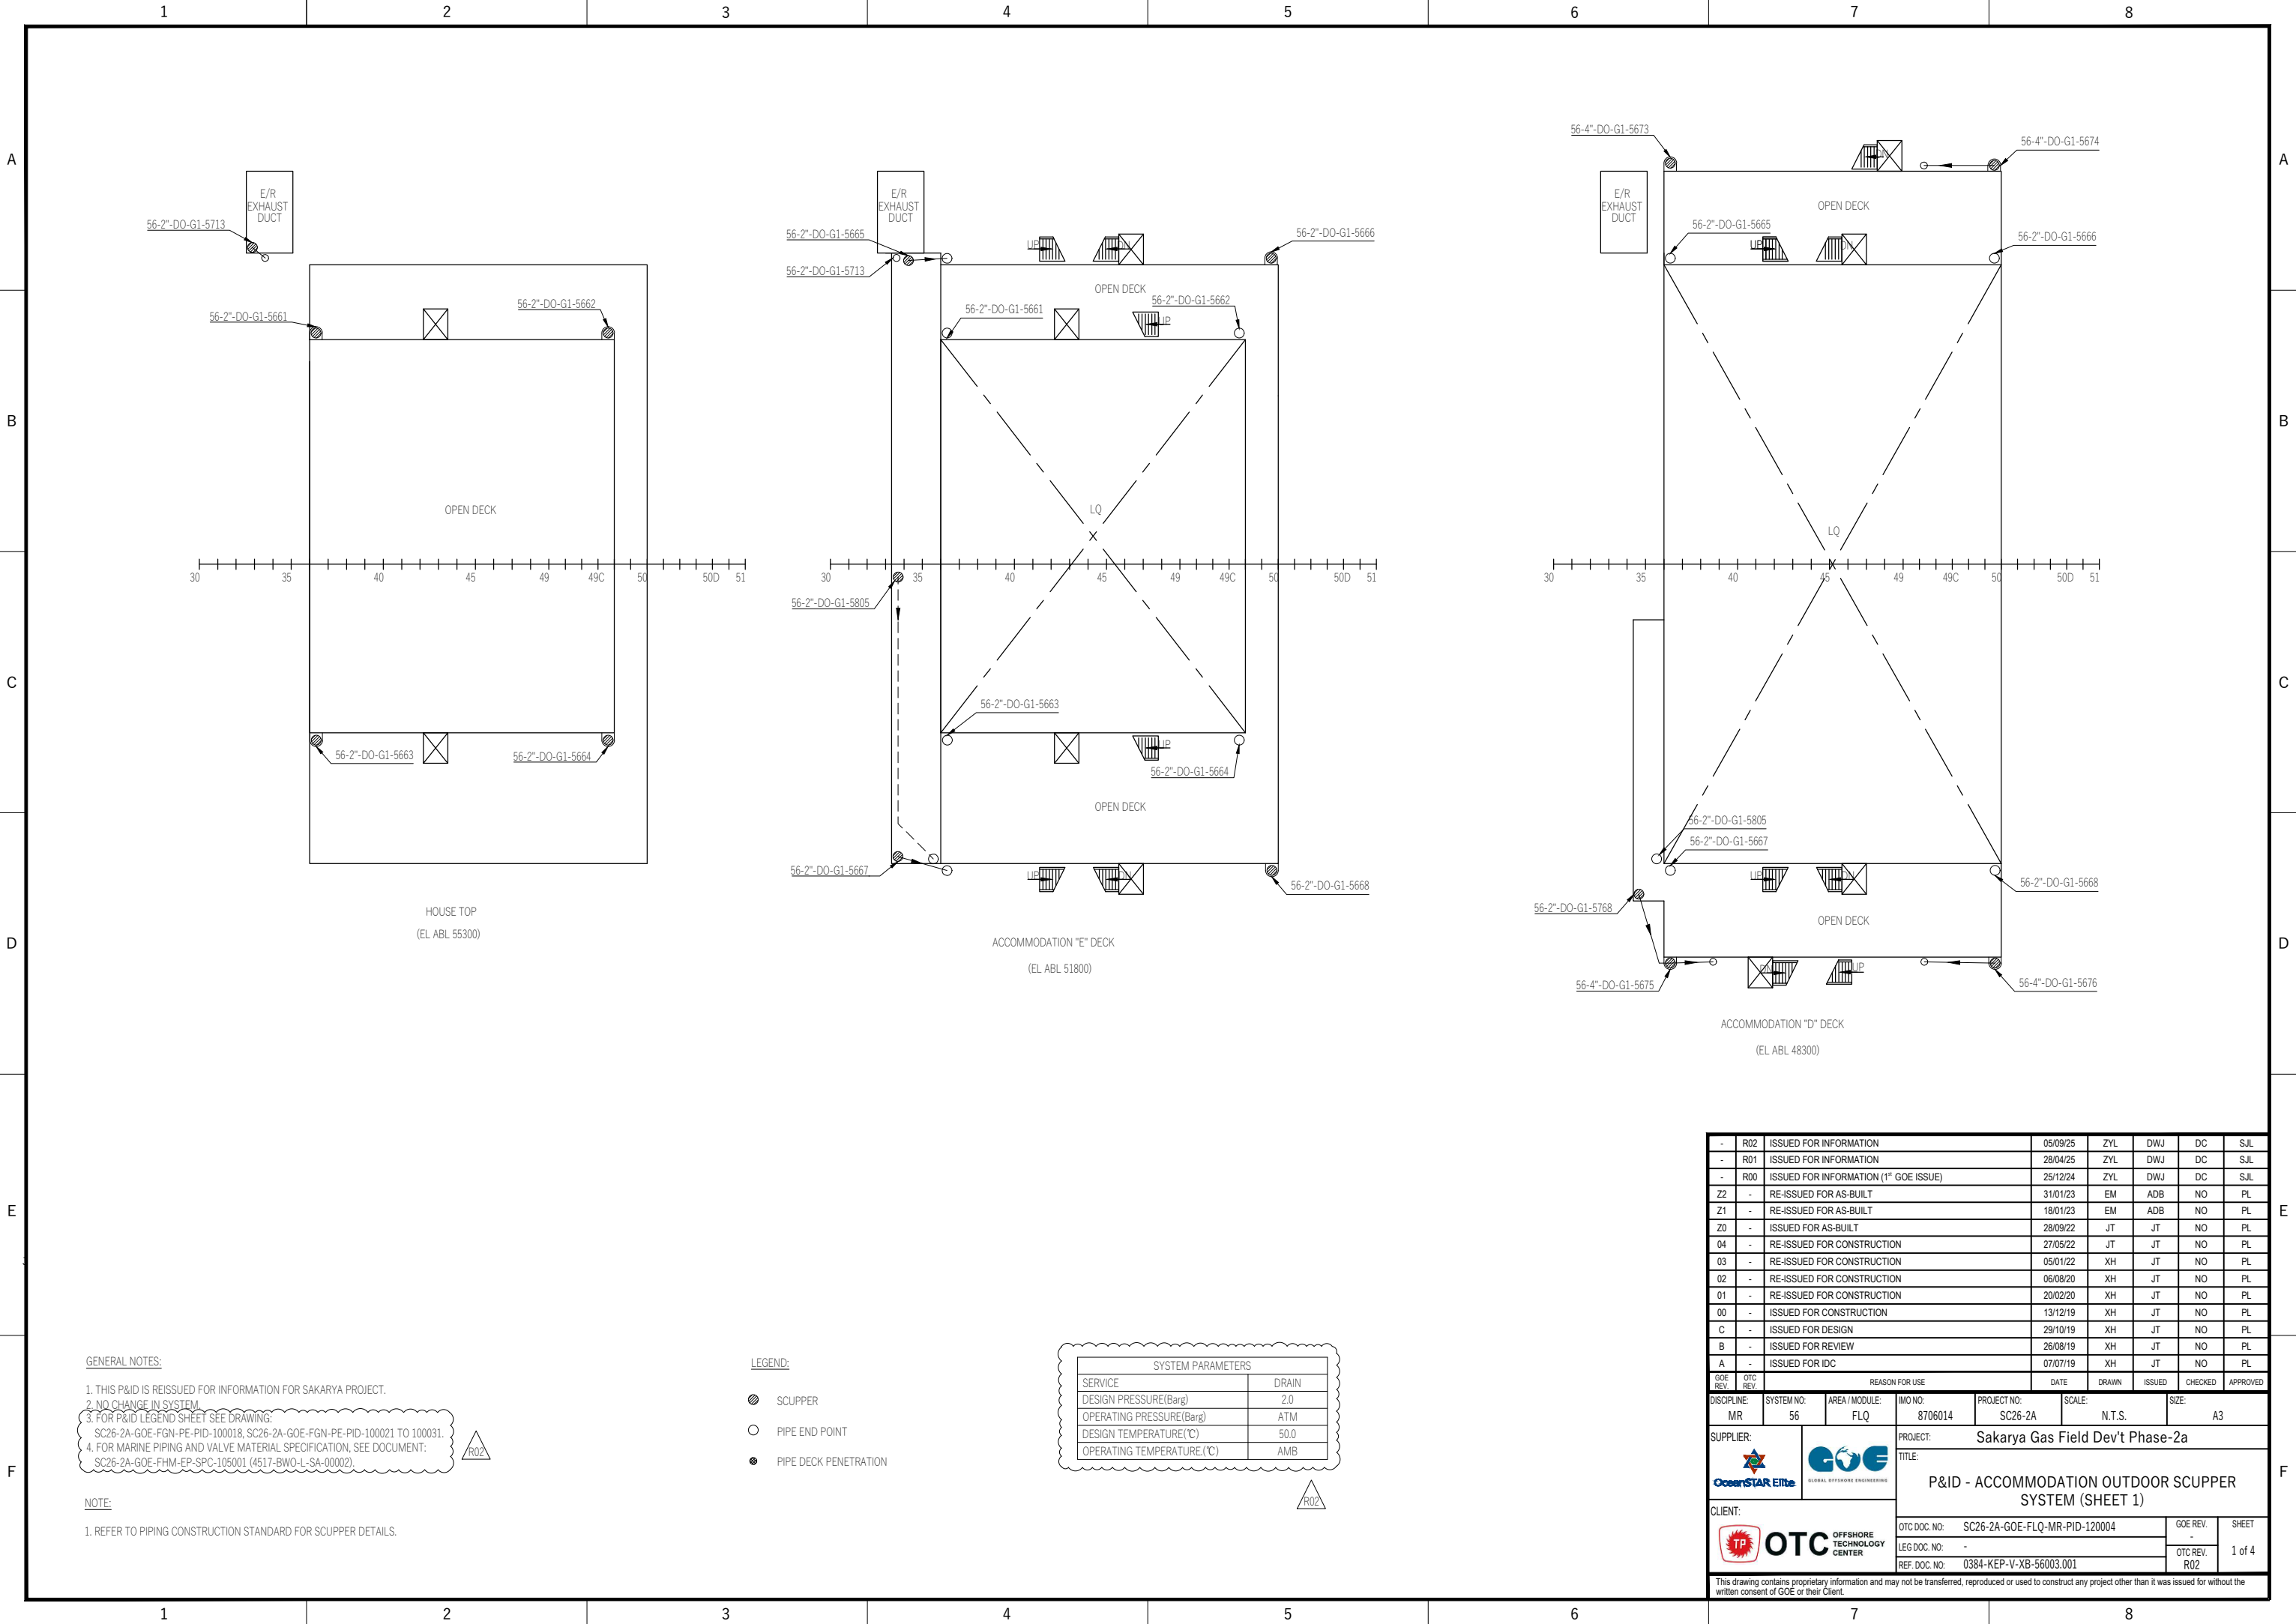

GENERAL NOTES:

- 1. THIS P&ID IS REISSUED FOR INFORMATION FOR SAKARYA PROJECT.
- 2. NO CHANGE IN SYSTEM.
- 3. FOR P&ID LEGEND SHEET SEE DRAWING:
SC26-2A-GOE-FGN-PE-PID-100018, SC26-2A-GOE-FGN-PE-PID-100021 TO 100031.
- 4. FOR MARINE PIPING AND VALVE MATERIAL SPECIFICATION, SEE DOCUMENT:
SC26-2A-GOE-FHM-EP-SPC-105001 (4517-BWO-L-SA-00002).

NOTE:

- 1. REFER TO PIPING CONSTRUCTION STANDARD FOR SCUPPER DETAILS.

LEGEND:

- SCUPPER
- PIPE END POINT
- PIPE DECK PENETRATION

SYSTEM PARAMETERS	
SERVICE	DRAIN
DESIGN PRESSURE(Barg)	2.0
OPERATING PRESSURE(Barg)	ATM
DESIGN TEMPERATURE(°C)	50.0
OPERATING TEMPERATURE(°C)	AMB

-	R02	ISSUED FOR INFORMATION		05/09/25	ZYL	DWJ	DC	SJL	
-	R01	ISSUED FOR INFORMATION		28/04/25	ZYL	DWJ	DC	SJL	
-	R00	ISSUED FOR INFORMATION (1 st GOE ISSUE)		25/12/24	ZYL	DWJ	DC	SJL	
Z2	-	RE-ISSUED FOR AS-BUILT		31/01/23	EM	ADB	NO	PL	
Z1	-	RE-ISSUED FOR AS-BUILT		18/01/23	EM	ADB	NO	PL	
Z0	-	ISSUED FOR AS-BUILT		28/09/22	JT	JT	NO	PL	
04	-	RE-ISSUED FOR CONSTRUCTION		27/05/22	JT	JT	NO	PL	
03	-	RE-ISSUED FOR CONSTRUCTION		05/01/22	XH	JT	NO	PL	
02	-	RE-ISSUED FOR CONSTRUCTION		06/08/20	XH	JT	NO	PL	
01	-	RE-ISSUED FOR CONSTRUCTION		20/02/20	XH	JT	NO	PL	
00	-	ISSUED FOR CONSTRUCTION		13/12/19	XH	JT	NO	PL	
C	-	ISSUED FOR DESIGN		29/10/19	XH	JT	NO	PL	
B	-	ISSUED FOR REVIEW		26/08/19	XH	JT	NO	PL	
A	-	ISSUED FOR IDC		07/07/19	XH	JT	NO	PL	
GOE REV.	OTC REV.	REASON FOR USE			DATE	DRAWN	ISSUED	CHECKED	APPROVED
DISCIPLINE:		SYSTEM NO:	AREA / MODULE:	IMO NO:	PROJECT NO:	SCALE:	SIZE:		
MR		56	FLQ	8706014	SC26-2A	N.T.S.	A3		
SUPPLIER:				PROJECT: Sakarya Gas Field Dev't Phase-2a					
 OCEANSTAR Elite				 GLOBAL OFFSHORE ENGINEERING					
CLIENT:				TITLE: P&ID - ACCOMMODATION OUTDOOR SCUPPER SYSTEM (SHEET 1)					
 OTC OFFSHORE TECHNOLOGY CENTER				OTC DOC. NO: SC26-2A-GOE-FLQ-MR-PID-120004			GOE REV. -		SHEET 1 of 4
				LEG DOC. NO: -			OTC REV. R02		
				REF. DOC. NO: 0384-KEP-V-XB-56003.001					
This drawing contains proprietary information and may not be transferred, reproduced or used to construct any project other than it was issued for without the written consent of GOE or their Client.									