


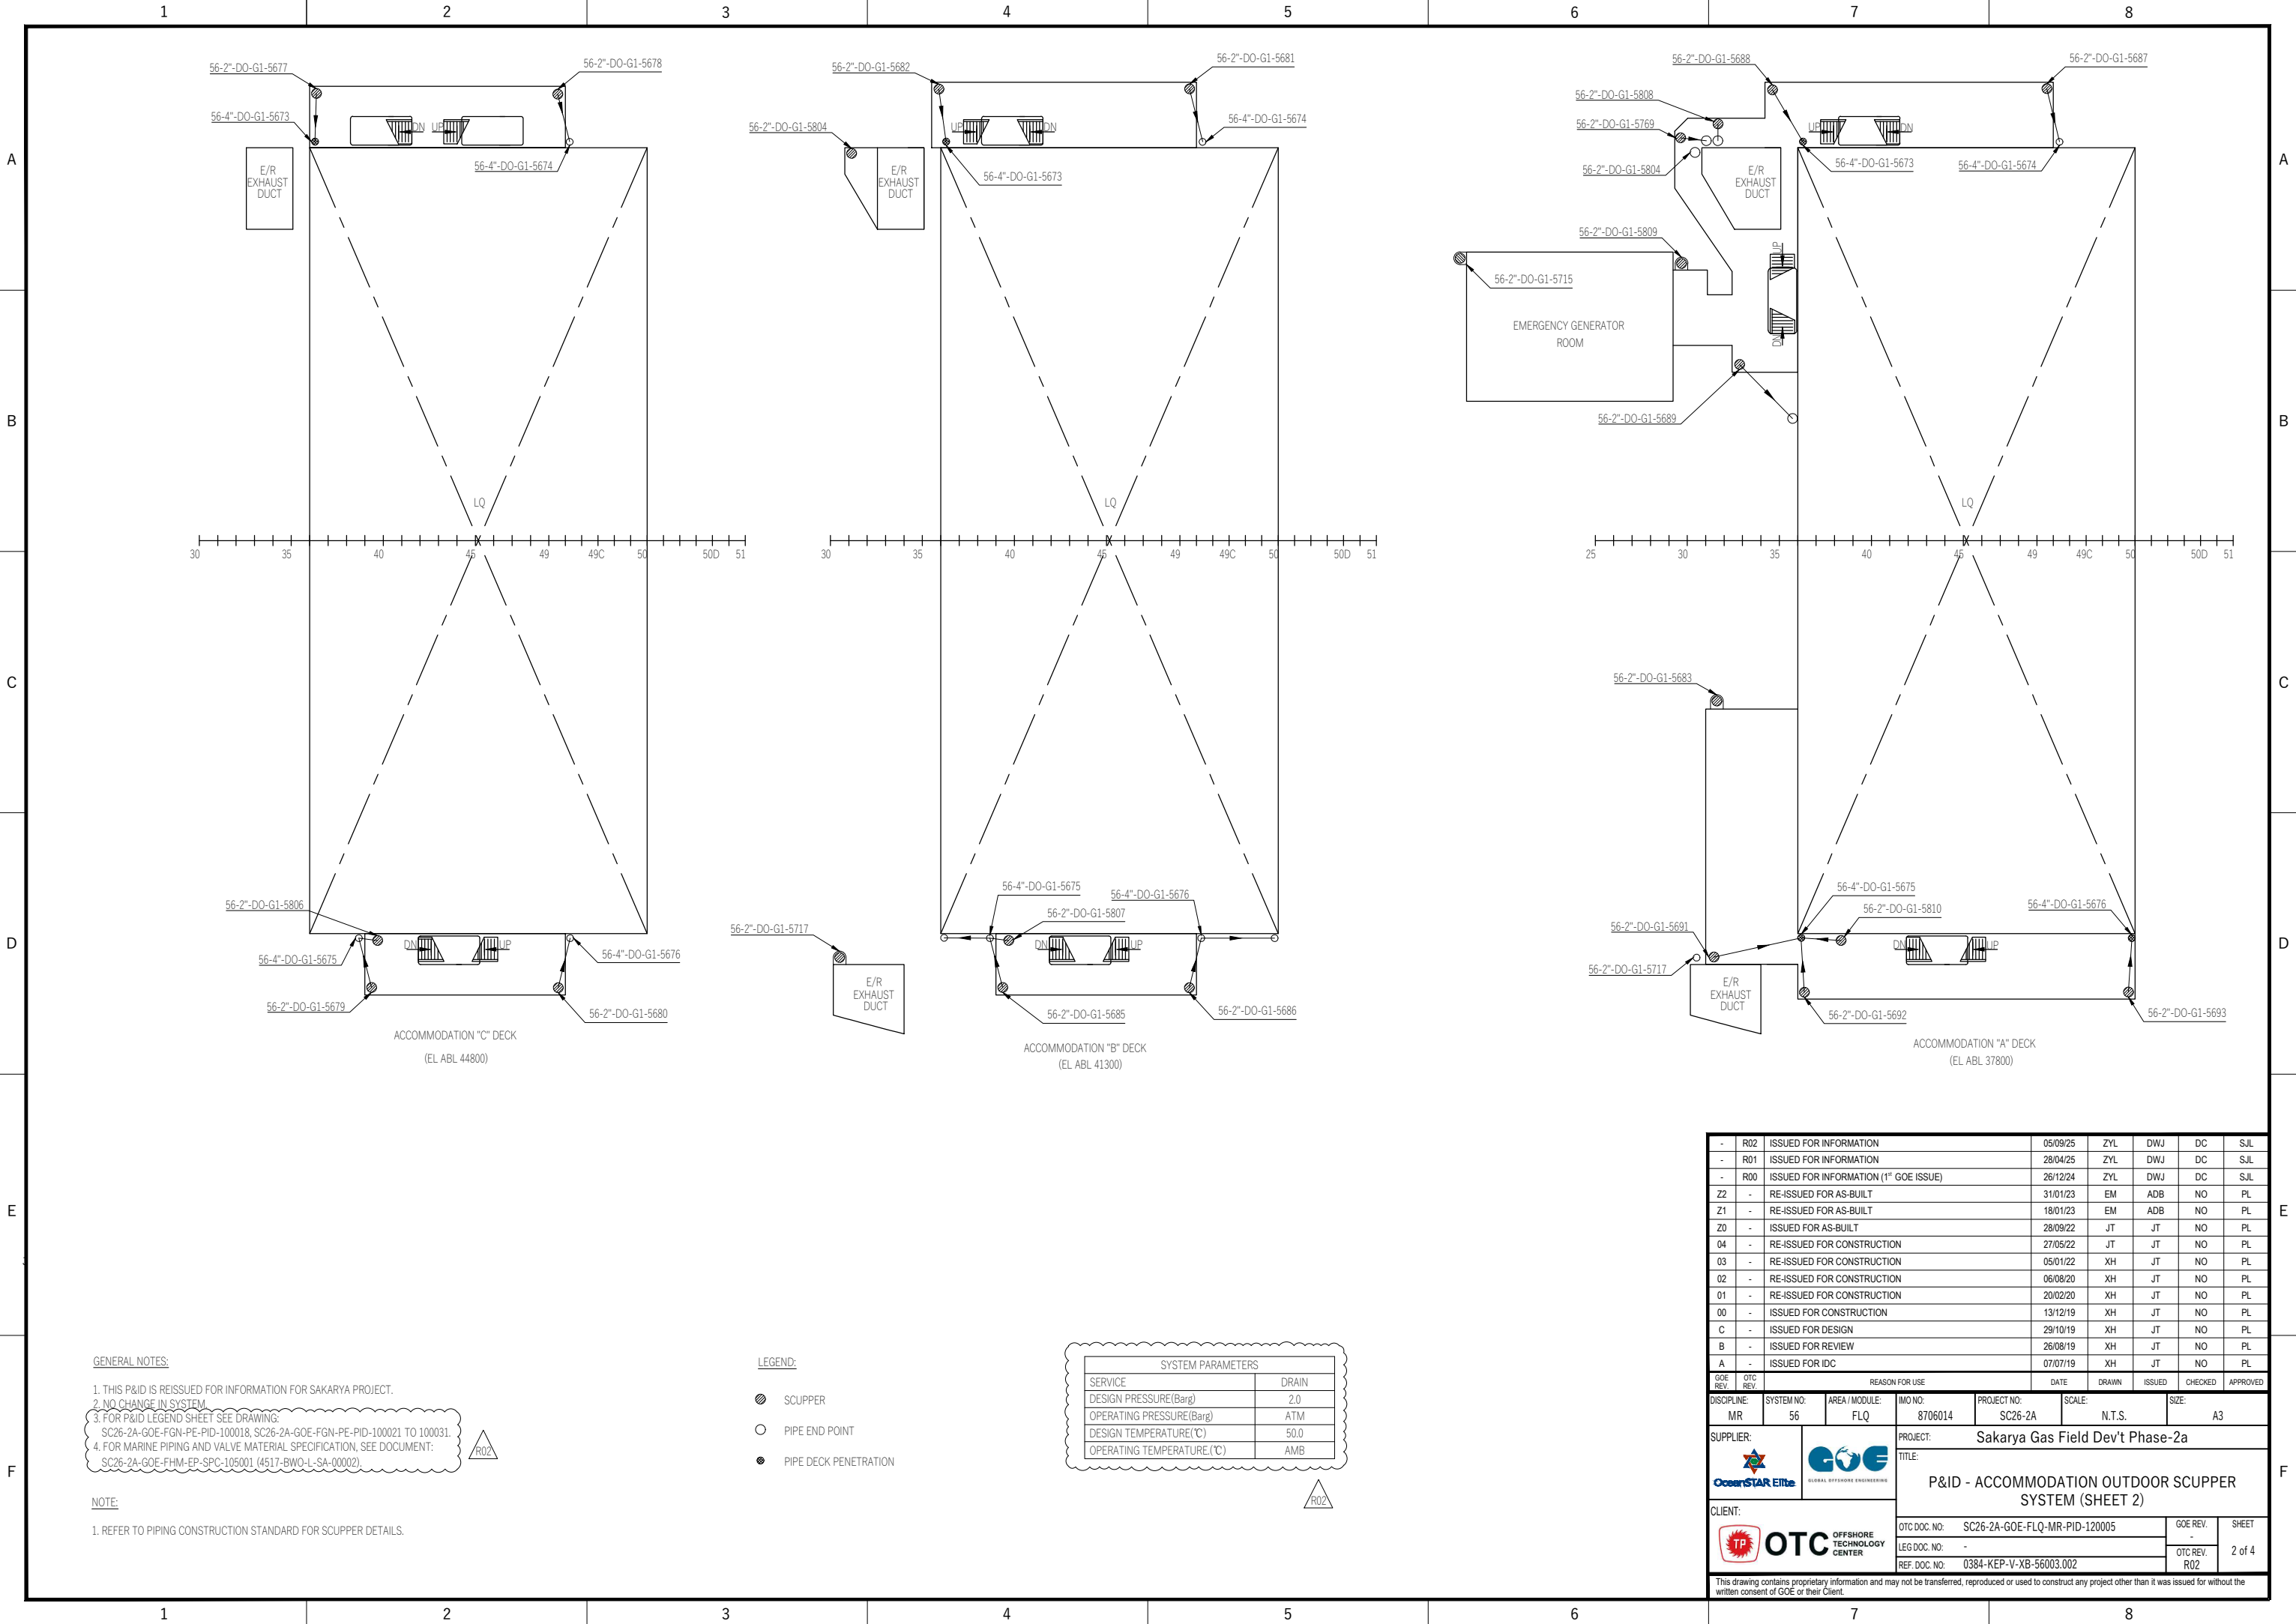

GENERAL NOTES:

1. THIS P&ID IS REISSUED FOR INFORMATION FOR SAKARYA PROJECT.
2. NO CHANGE IN SYSTEM.
3. FOR P&ID LEGEND SHEET SEE DRAWING: SC26-2A-GOE-FGN-PE-PID-100018, SC26-2A-GOE-FGN-PE-PID-100021 TO 100031.
4. FOR MARINE PIPING AND VALVE MATERIAL SPECIFICATION, SEE DOCUMENT: SC26-2A-GOE-FHM-EP-SPC-105001 (4517-BWO-L-SA-00002).

NOTE:

1. REFER TO PIPING CONSTRUCTION STANDARD FOR SCUPPER DETAILS.

LEGEND:

- SCUPPER
- PIPE END POINT
- PIPE DECK PENETRATION

| SYSTEM PARAMETERS         |       |
|---------------------------|-------|
| SERVICE                   | DRAIN |
| DESIGN PRESSURE(Barg)     | 2.0   |
| OPERATING PRESSURE(Barg)  | ATM   |
| DESIGN TEMPERATURE(°C)    | 50.0  |
| OPERATING TEMPERATURE(°C) | AMB   |

|                                                                                       |          |                                                    |                |                                                              |             |        |       |        |         |          |
|---------------------------------------------------------------------------------------|----------|----------------------------------------------------|----------------|--------------------------------------------------------------|-------------|--------|-------|--------|---------|----------|
| -                                                                                     | R02      | ISSUED FOR INFORMATION                             |                | 05/09/25                                                     |             | ZYL    | DWJ   | DC     | SJL     |          |
| -                                                                                     | R01      | ISSUED FOR INFORMATION                             |                | 28/04/25                                                     |             | ZYL    | DWJ   | DC     | SJL     |          |
| -                                                                                     | R00      | ISSUED FOR INFORMATION (1 <sup>st</sup> GOE ISSUE) |                | 26/12/24                                                     |             | ZYL    | DWJ   | DC     | SJL     |          |
| Z2                                                                                    | -        | RE-ISSUED FOR AS-BUILT                             |                | 31/01/23                                                     |             | EM     | ADB   | NO     | PL      |          |
| Z1                                                                                    | -        | RE-ISSUED FOR AS-BUILT                             |                | 18/01/23                                                     |             | EM     | ADB   | NO     | PL      |          |
| Z0                                                                                    | -        | ISSUED FOR AS-BUILT                                |                | 28/09/22                                                     |             | JT     | JT    | NO     | PL      |          |
| 04                                                                                    | -        | RE-ISSUED FOR CONSTRUCTION                         |                | 27/05/22                                                     |             | JT     | JT    | NO     | PL      |          |
| 03                                                                                    | -        | RE-ISSUED FOR CONSTRUCTION                         |                | 05/01/22                                                     |             | XH     | JT    | NO     | PL      |          |
| 02                                                                                    | -        | RE-ISSUED FOR CONSTRUCTION                         |                | 06/08/20                                                     |             | XH     | JT    | NO     | PL      |          |
| 01                                                                                    | -        | RE-ISSUED FOR CONSTRUCTION                         |                | 20/02/20                                                     |             | XH     | JT    | NO     | PL      |          |
| 00                                                                                    | -        | ISSUED FOR CONSTRUCTION                            |                | 13/12/19                                                     |             | XH     | JT    | NO     | PL      |          |
| C                                                                                     | -        | ISSUED FOR DESIGN                                  |                | 29/10/19                                                     |             | XH     | JT    | NO     | PL      |          |
| B                                                                                     | -        | ISSUED FOR REVIEW                                  |                | 26/08/19                                                     |             | XH     | JT    | NO     | PL      |          |
| A                                                                                     | -        | ISSUED FOR IDC                                     |                | 07/07/19                                                     |             | XH     | JT    | NO     | PL      |          |
| GOE REV.                                                                              | OTC REV. | REASON FOR USE                                     |                |                                                              |             | DATE   | DRAWN | ISSUED | CHECKED | APPROVED |
| DISCIPLINE:                                                                           |          | SYSTEM NO:                                         | AREA / MODULE: | MO NO:                                                       | PROJECT NO: | SCALE: |       | SIZE:  |         |          |
| MR                                                                                    |          | 56                                                 | FLQ            | 8706014                                                      | SC26-2A     | N.T.S. |       | A3     |         |          |
| SUPPLIER:                                                                             |          |                                                    |                | PROJECT: Sakarya Gas Field Dev't Phase-2a                    |             |        |       |        |         |          |
|  |          |                                                    |                | TITLE: P&ID - ACCOMMODATION OUTDOOR SCUPPER SYSTEM (SHEET 2) |             |        |       |        |         |          |
|  |          |                                                    |                |                                                              |             |        |       |        |         |          |
| CLIENT:                                                                               |          |                                                    |                | PROJECT: Sakarya Gas Field Dev't Phase-2a                    |             |        |       |        |         |          |
|  |          |                                                    |                | TITLE: P&ID - ACCOMMODATION OUTDOOR SCUPPER SYSTEM (SHEET 2) |             |        |       |        |         |          |
|  |          |                                                    |                | PROJECT: Sakarya Gas Field Dev't Phase-2a                    |             |        |       |        |         |          |
| OFFSHORE TECHNOLOGY CENTER                                                            |          |                                                    |                | PROJECT: Sakarya Gas Field Dev't Phase-2a                    |             |        |       |        |         |          |
|                                                                                       |          |                                                    |                | PROJECT: Sakarya Gas Field Dev't Phase-2a                    |             |        |       |        |         |          |
|                                                                                       |          |                                                    |                | PROJECT: Sakarya Gas Field Dev't Phase-2a                    |             |        |       |        |         |          |
|                                                                                       |          |                                                    |                |                                                              |             |        |       |        |         |          |