


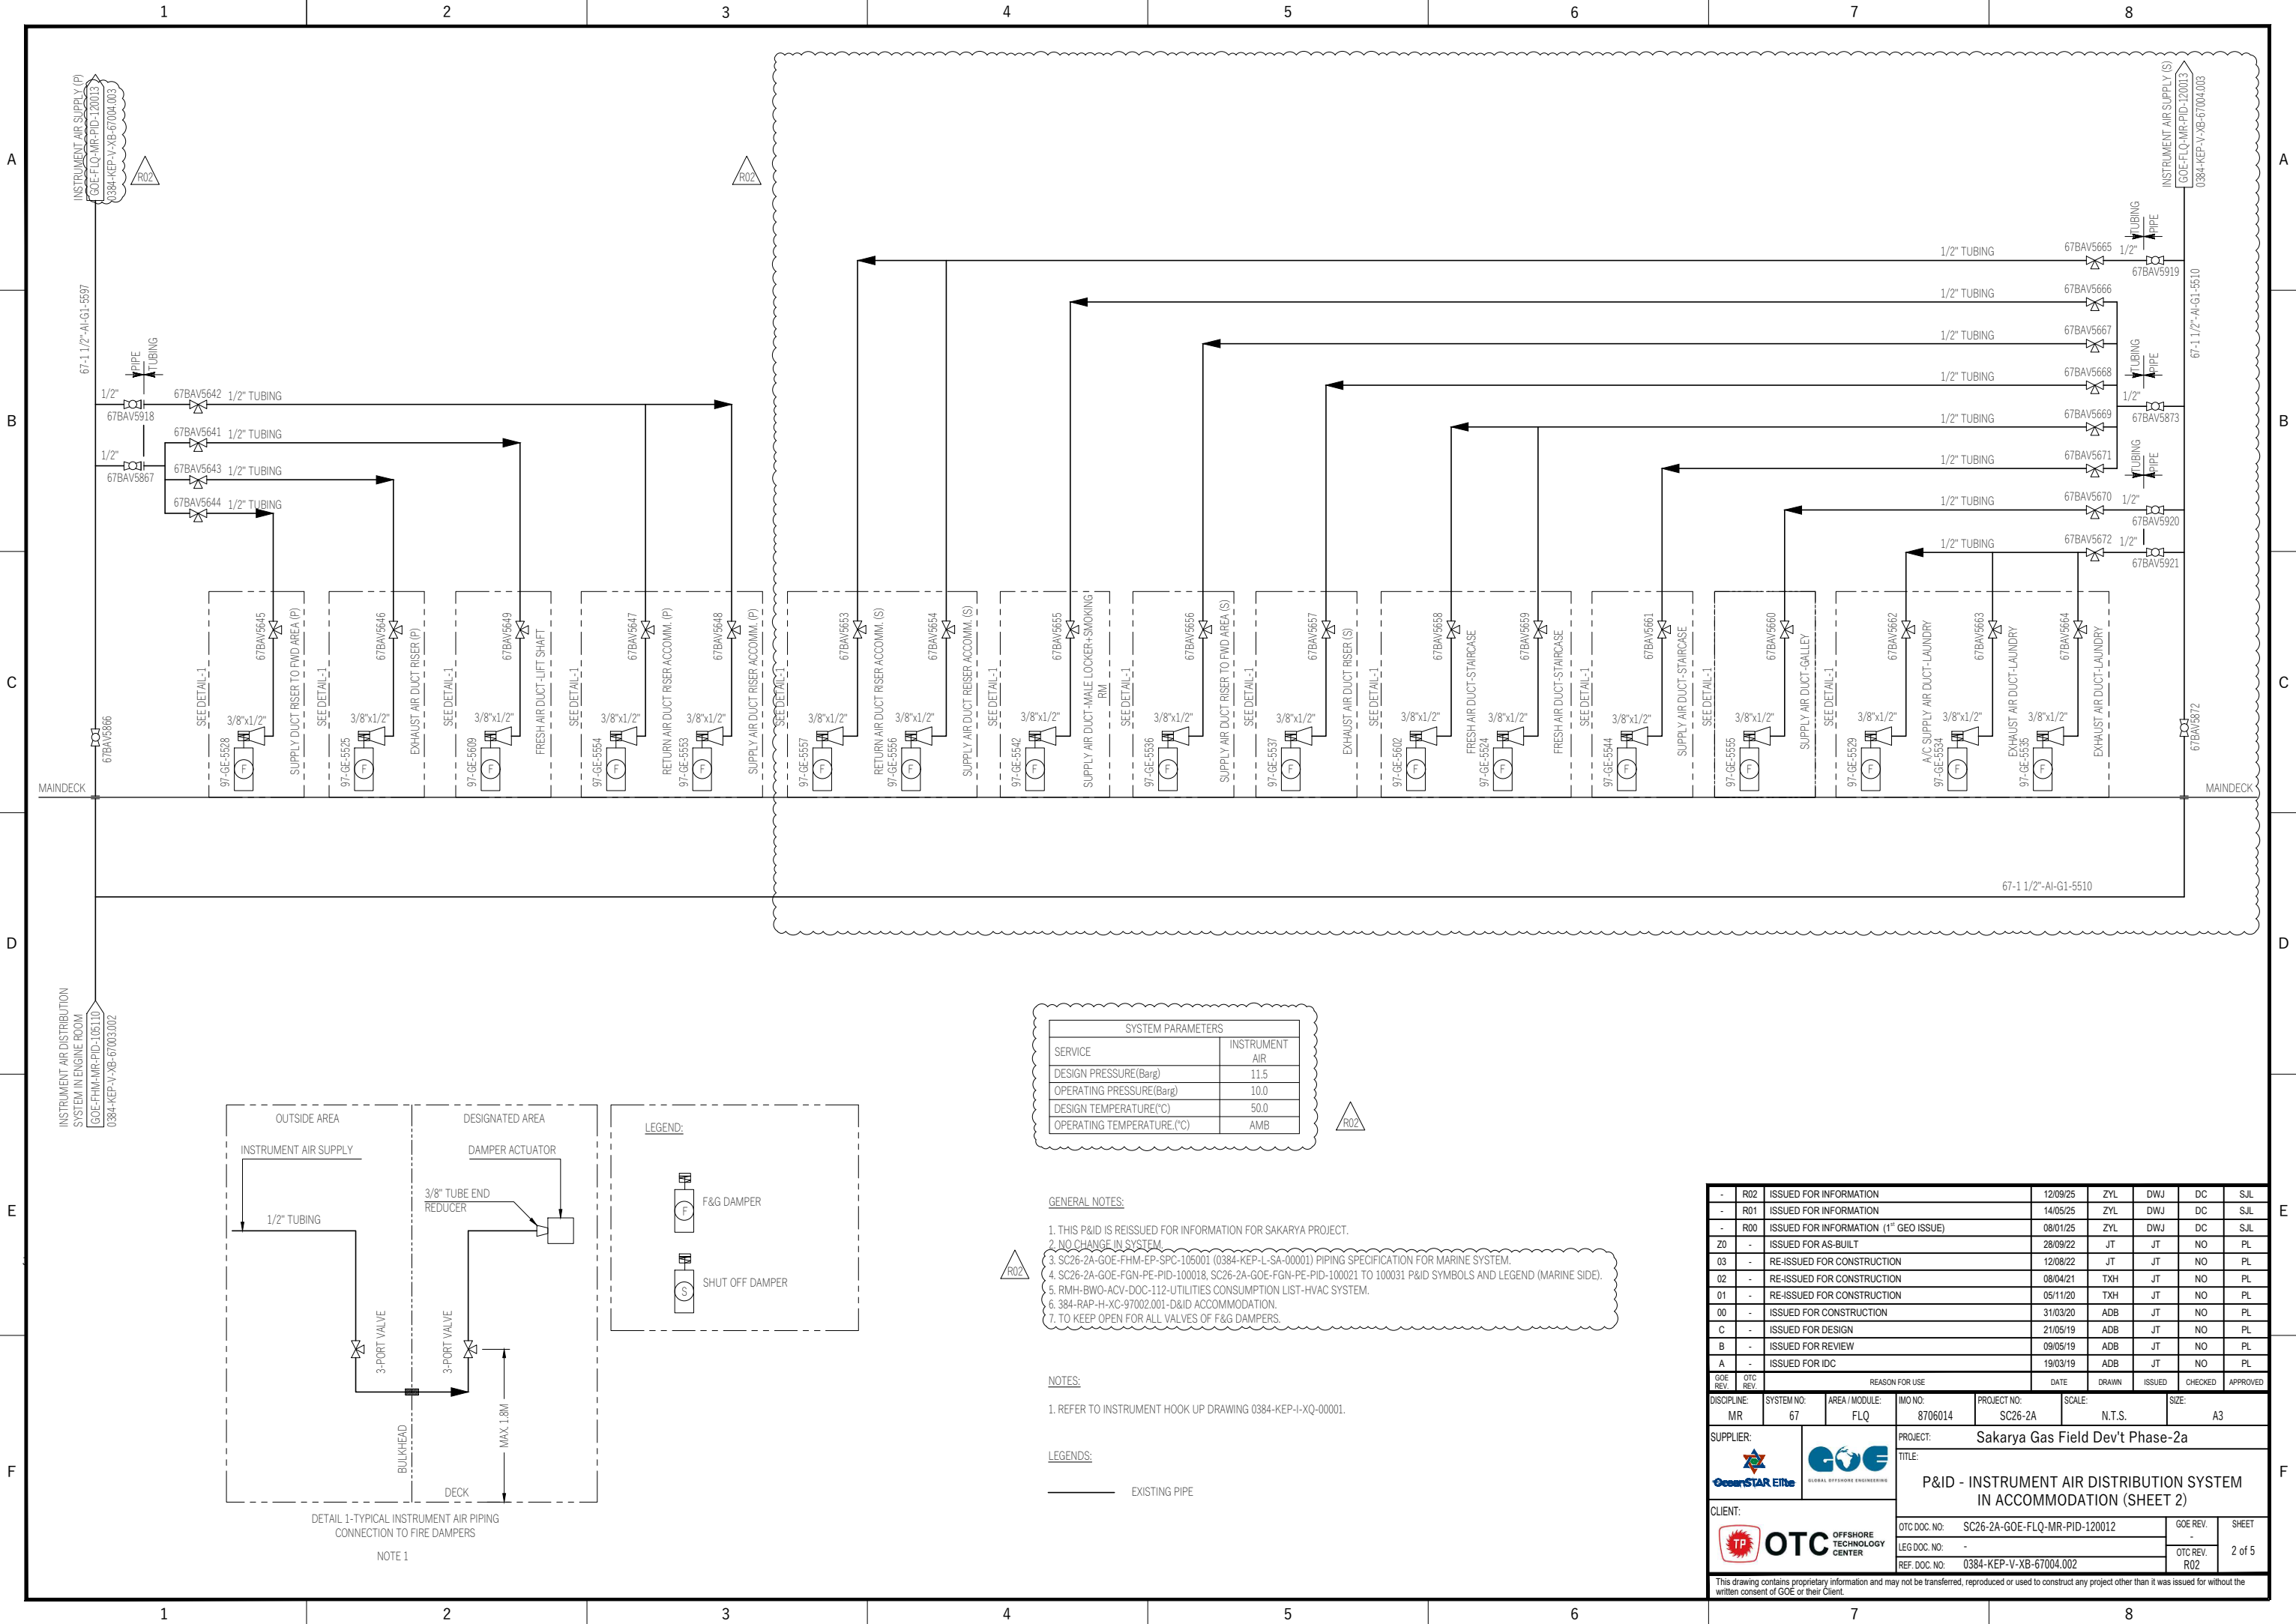

SYSTEM PARAMETERS	
SERVICE	INSTRUMENT AIR
DESIGN PRESSURE(Barg)	11.5
OPERATING PRESSURE(Barg)	10.0
DESIGN TEMPERATURE(°C)	50.0
OPERATING TEMPERATURE(°C)	AMB

- GENERAL NOTES:
- THIS P&ID IS REISSUED FOR INFORMATION FOR SAKARYA PROJECT.
 - NO CHANGE IN SYSTEM.
 - SC26-2A-GOE-FHM-EP-SPC-105001 (0384-KEP-L-SA-00001) PIPING SPECIFICATION FOR MARINE SYSTEM.
 - SC26-2A-GOE-FGN-PE-PID-100018, SC26-2A-GOE-FGN-PE-PID-100021 TO 100031 P&ID SYMBOLS AND LEGEND (MARINE SIDE).
 - RMH-BWO-ACV-DOC-112-UTILITIES CONSUMPTION LIST-HVAC SYSTEM.
 - 384-RAP-H-XC-97002.001-D&ID ACCOMMODATION.
 - TO KEEP OPEN FOR ALL VALVES OF F&G DAMPERS.

- NOTES:
- REFER TO INSTRUMENT HOOK UP DRAWING 0384-KEP-I-XQ-00001.

- LEGENDS:
- EXISTING PIPE

-	R02	ISSUED FOR INFORMATION		12/09/25	ZYL	DWJ	DC	SJL	
-	R01	ISSUED FOR INFORMATION		14/05/25	ZYL	DWJ	DC	SJL	
-	R00	ISSUED FOR INFORMATION (1 st GEO ISSUE)		08/01/25	ZYL	DWJ	DC	SJL	
Z0	-	ISSUED FOR AS-BUILT		28/09/22	JT	JT	NO	PL	
03	-	RE-ISSUED FOR CONSTRUCTION		12/08/22	JT	JT	NO	PL	
02	-	RE-ISSUED FOR CONSTRUCTION		08/04/21	TXH	JT	NO	PL	
01	-	RE-ISSUED FOR CONSTRUCTION		05/11/20	TXH	JT	NO	PL	
00	-	ISSUED FOR CONSTRUCTION		31/03/20	ADB	JT	NO	PL	
C	-	ISSUED FOR DESIGN		21/05/19	ADB	JT	NO	PL	
B	-	ISSUED FOR REVIEW		09/05/19	ADB	JT	NO	PL	
A	-	ISSUED FOR IDC		19/03/19	ADB	JT	NO	PL	
GOE REV.	OTC REV.	REASON FOR USE			DATE	DRAWN	ISSUED	CHECKED	APPROVED
DISCIPLINE:	SYSTEM NO:	AREA / MODULE:	IMO NO:	PROJECT NO:	SCALE:	SIZE:			
MR	67	FLQ	8706014	SC26-2A	N.T.S.	A3			
SUPPLIER:			PROJECT: Sakarya Gas Field Dev't Phase-2a						
 OceanoSTAR Elite GLOBAL OFFSHORE ENGINEERING			TITLE: P&ID - INSTRUMENT AIR DISTRIBUTION SYSTEM IN ACCOMMODATION (SHEET 2)						
CLIENT:			OTC DOC. NO: SC26-2A-GOE-FLQ-MR-PID-120012						
 OTC OFFSHORE TECHNOLOGY CENTER			LEG DOC. NO: -				GOE REV.:	SHEET	
			REF. DOC. NO: 0384-KEP-V-XB-67004.002				OTC REV. R02	2 of 5	
This drawing contains proprietary information and may not be transferred, reproduced or used to construct any project other than it was issued for without the written consent of GOE or their Client.									