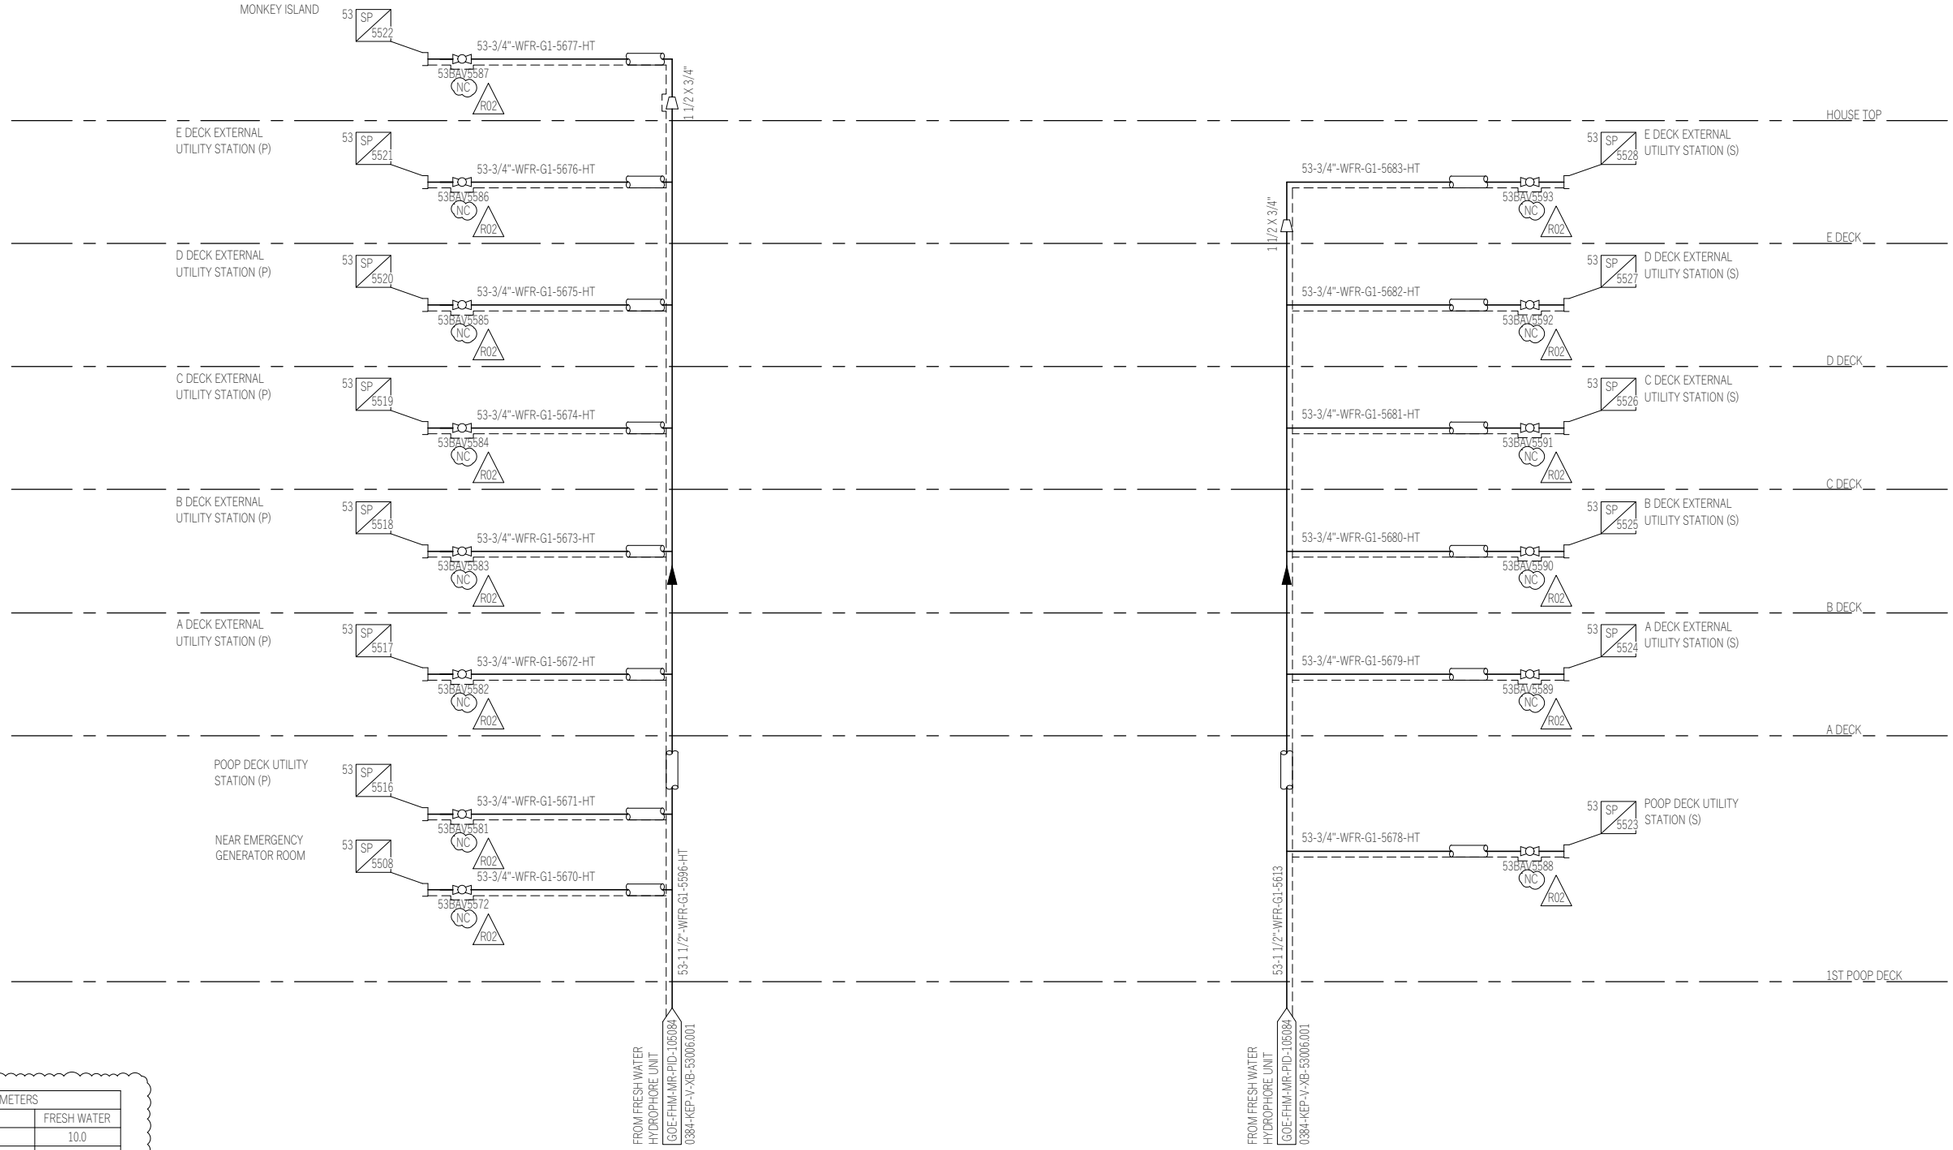


SYSTEM PARAMETERS	
SERVICE	FRESH WATER
DESIGN PRESSURE(Barg)	10.0
OPERATING PRESSURE(Barg)	8.0
DESIGN TEMPERATURE(°C)	50.0
OPERATING TEMPERATURE.(°C)	32

R02

R02

GENERAL NOTES:

1. THIS P&ID IS REISSUED FOR INFORMATION FOR SAKARYA PROJECT.
2. NO CHANGE IN SYSTEM.
3. FOR P&ID LEGEND SHEET SEE DRAWING: SC26-2A-GOE-FGN-PE-PID-100018, SC26-2A-GOE-FGN-PE-PID-100021 TO 100031.
4. FOR MARINE PIPING AND VALVE MATERIAL SPECIFICATION, SEE DOCUMENT: SC26-2A-GOE-FHM-EP-SPC-105001 (4517-BWO-L-SA-00002).

R02

LEGENDS:

EXISTING PIPE

GOE REV.	OTC REV.	REASON FOR USE	DATE	DRAWN	ISSUED	CHECKED	APPROVED
-	R02	ISSUED FOR INFORMATION	02/09/25	ZYL	DWJ	DC	SJL
-	R01	ISSUED FOR INFORMATION	08/05/25	ZYL	DWJ	DC	SJL
-	R00	ISSUED FOR INFORMATION (1st GOE ISSUE)	24/12/24	ZYL	DWJ	DC	SJL
Z0	-	ISSUED FOR AS-BUILT	28/09/22	JT	JT	NO	PL
02	-	RE-ISSUED FOR CONSTRUCTION	08/04/21	XH	JT	NO	PL
01	-	RE-ISSUED FOR CONSTRUCTION	30/10/20	XH	JT	NO	PL
00	-	ISSUED FOR CONSTRUCTION	09/10/19	XH	JT	NO	PL
C	-	ISSUED FOR DESIGN	20/08/19	XH	JT	NO	PL
B	-	ISSUED FOR REVIEW	22/07/19	XH	JT	NO	PL
A	-	ISSUED FOR IDC	16/04/19	TT	JT	NO	PL

DISCIPLINE:	SYSTEM NO:	AREA / MODULE:	IMO NO:	PROJECT NO:	SCALE:	SIZE:
MR	53	FHM	8706014	SC26-2A	N.T.S.	A3

SUPPLIER: OceanSTAR Elite | GOE GLOBAL OFFSHORE ENGINEERING

CLIENT: TP OTC OFFSHORE TECHNOLOGY CENTER

PROJECT: Sakarya Gas Field Dev't Phase-2a

TITLE: P&ID - FRESH WATER DISTRIBUTION FOR ENGINE ROOM AND ACCOMMODATION (SHEET 2)

OTC DOC. NO:	SC26-2A-GOE-FHM-MR-PID-105085	GOE REV.	SHEET
LEG DOC. NO:	-	-	2 of 2
REF. DOC. NO:	0384-KEP-V-XB-53006.002	OTC REV.	
		R02	

This drawing contains proprietary information and may not be transferred, reproduced or used to construct any project other than it was issued for without the written consent of GOE or their Client.

CODE 1 - Accepted without Comment - 04/10/2026 12:24:13 Internal