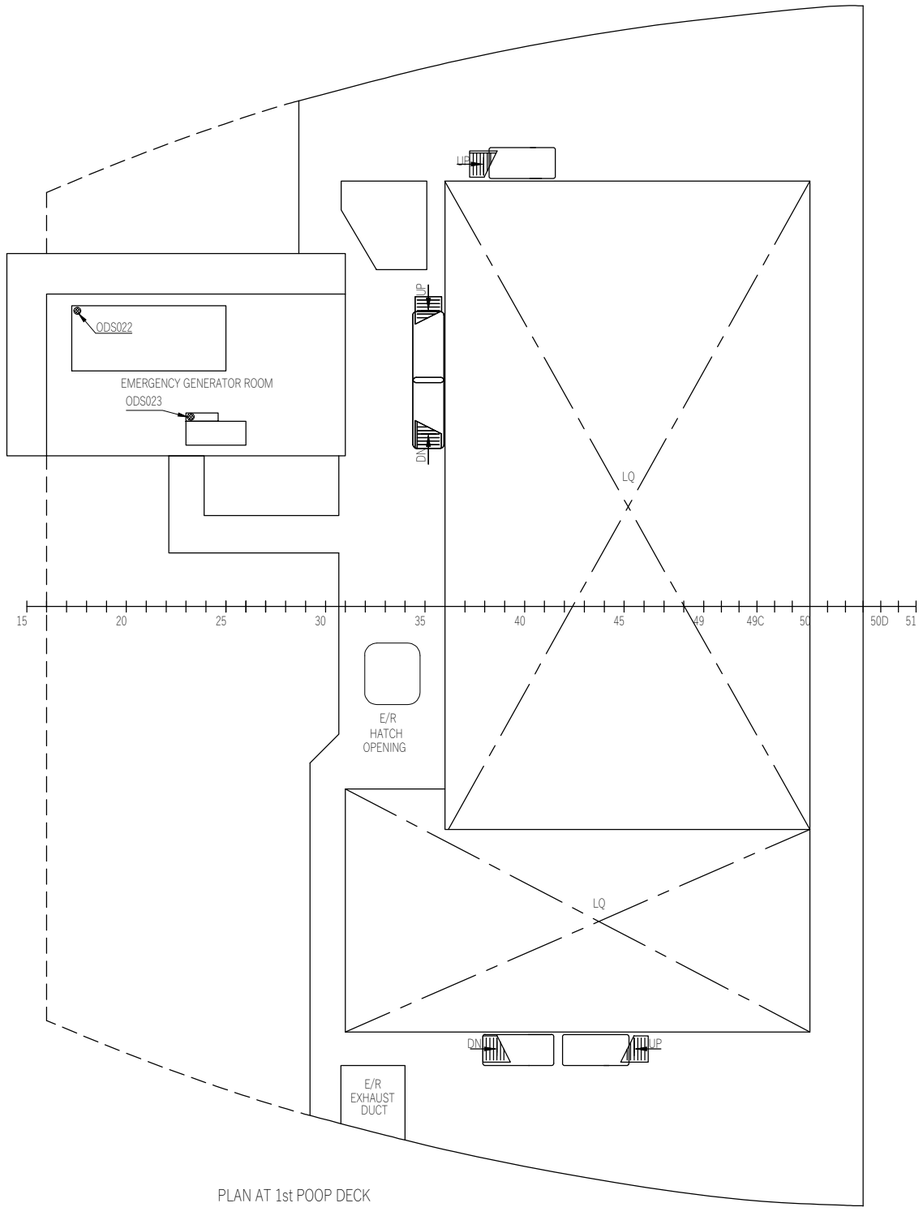

PLAN AT 1st POOP DECK

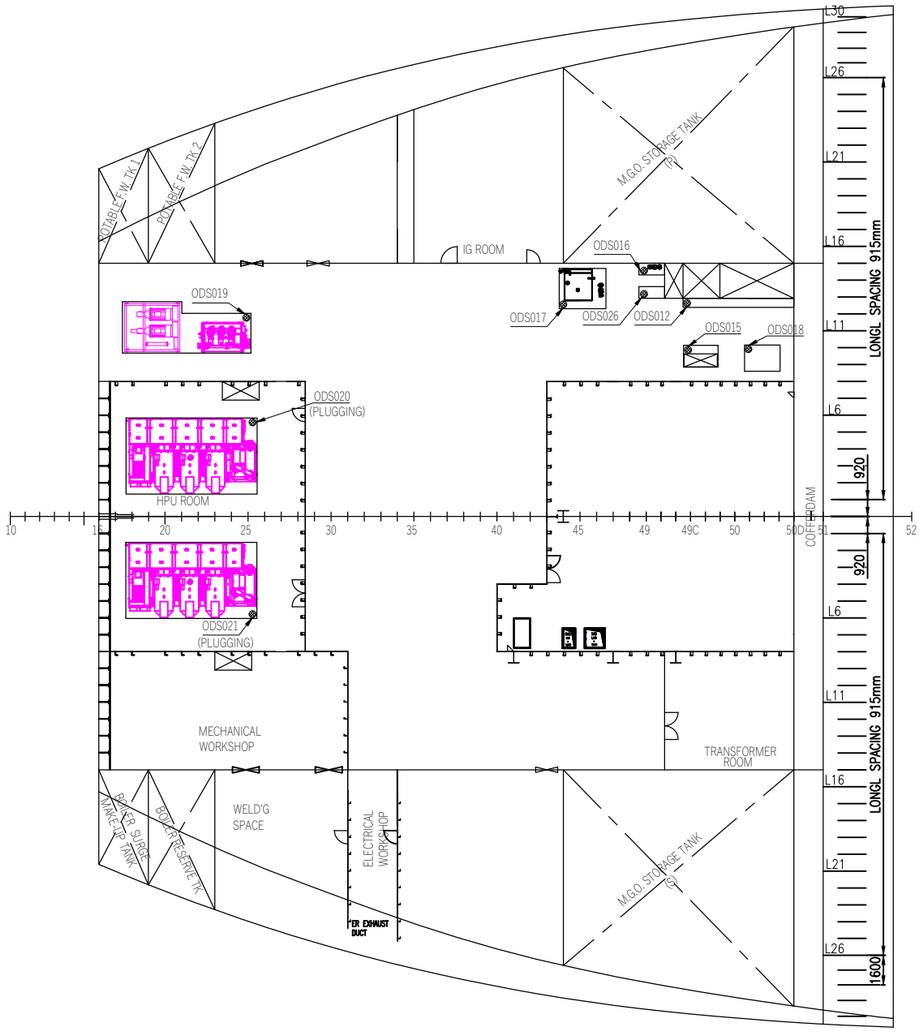

PLAN AT 1st PLATFORM DECK

GENERAL NOTES:

1. THIS P&ID IS REISSUED FOR INFORMATION FOR SAKARYA PROJECT.
2. NO CHANGE IN SYSTEM.
3. FOR P&ID LEGEND SHEET SEE DRAWING:
   SC26-2A-GOE-FGN-PE-PID-100018, SC26-2A-GOE-FGN-PE-PID-100021 TO 100031.
4. FOR MARINE PIPING AND VALVE MATERIAL SPECIFICATION, SEE DOCUMENT:
   SC26-2A-GOE-FHM-EP-SPC-105001 (4517-BWO-L-SA-00002).

R02

LEGEND:

- COAMING SCUPPER

GOE REV.	OTC REV.	REASON FOR USE	DATE	DRAWN	ISSUED	CHECKED	APPROVED
-	R02	ISSUED FOR INFORMATION	09/09/25	ZYL	DWJ	DC	SJL
-	R01	ISSUED FOR INFORMATION	28/04/25	ZYL	DWJ	DC	SJL
-	R00	ISSUED FOR INFORMATION (1ST GOE ISSUE)	27/12/24	ZYL	DWJ	DC	SJL
Z0	-	ISSUED FOR AS-BUILT	28/09/22	JT	JT	NO	PL
01	-	RE-ISSUED FOR CONSTRUCTION	28/12/20	XH	JT	NO	PL
00	-	ISSUED FOR CONSTRUCTION	31/01/20	XH	JT	NO	PL
C	-	ISSUED FOR DESIGN	07/11/19	XH	JT	NO	PL
B	-	ISSUED FOR APPROVAL	06/03/19	BL	JT	NO	PL
A	-	ISSUED FOR IDC	15/02/19	BL	JT	NO	PL

DISCIPLINE:	SYSTEM NO:	AREA / MODULE:	IMO NO:	PROJECT NO:	SCALE:	SIZE:
MR	56	FHM	8706014	SC26-2A	N.T.S.	A3

SUPPLIER: OceanSTAR Elite / GOE GLOBAL OFFSHORE ENGINEERING

PROJECT: Sakarya Gas Field Dev't Phase-2a

TITLE: P&ID - OIL DRAIN SYSTEM IN ENGINE ROOM (SHEET 2)

CLIENT: TP OTC OFFSHORE TECHNOLOGY CENTER

		GOE REV.	SHEET
OTC DOC. NO:	SC26-2A-GOE-FHM-MR-PID-105089	-	2 of 3
LEG DOC. NO:	-	OTC REV.	
REF. DOC. NO:	0384-KEP-V-XB-56005.002	R02	

This drawing contains proprietary information and may not be transferred, reproduced or used to construct any project other than it was issued for without the written consent of GOE or their Client.