
EQUIP. TAG	62PS5502A/B	
EQUIP. NAME	M.G.O. TRANSFER PUMP	
CAPACITY	22.2 m3/h	
CONFIGURATION	2 x 100%	
OPERATING (DESIGN) PRESSURE	6 (7)	BARG
OPERATING (DESIGN) TEMP.		℃
DUTY POWER	7.5	kW
MATERIAL		

SYSTEM PARAMETERS		
SERVICE	PUMP DISCHARGE	PUMP SUCTION
DESIGN PRESSURE(Barg)	7.0	3.5
OPERATING PRESSURE(Barg)	6	2
DESIGN TEMPERATURE(℃)	50.0	50.0
OPERATING TEMPERATURE.(℃)	50	50

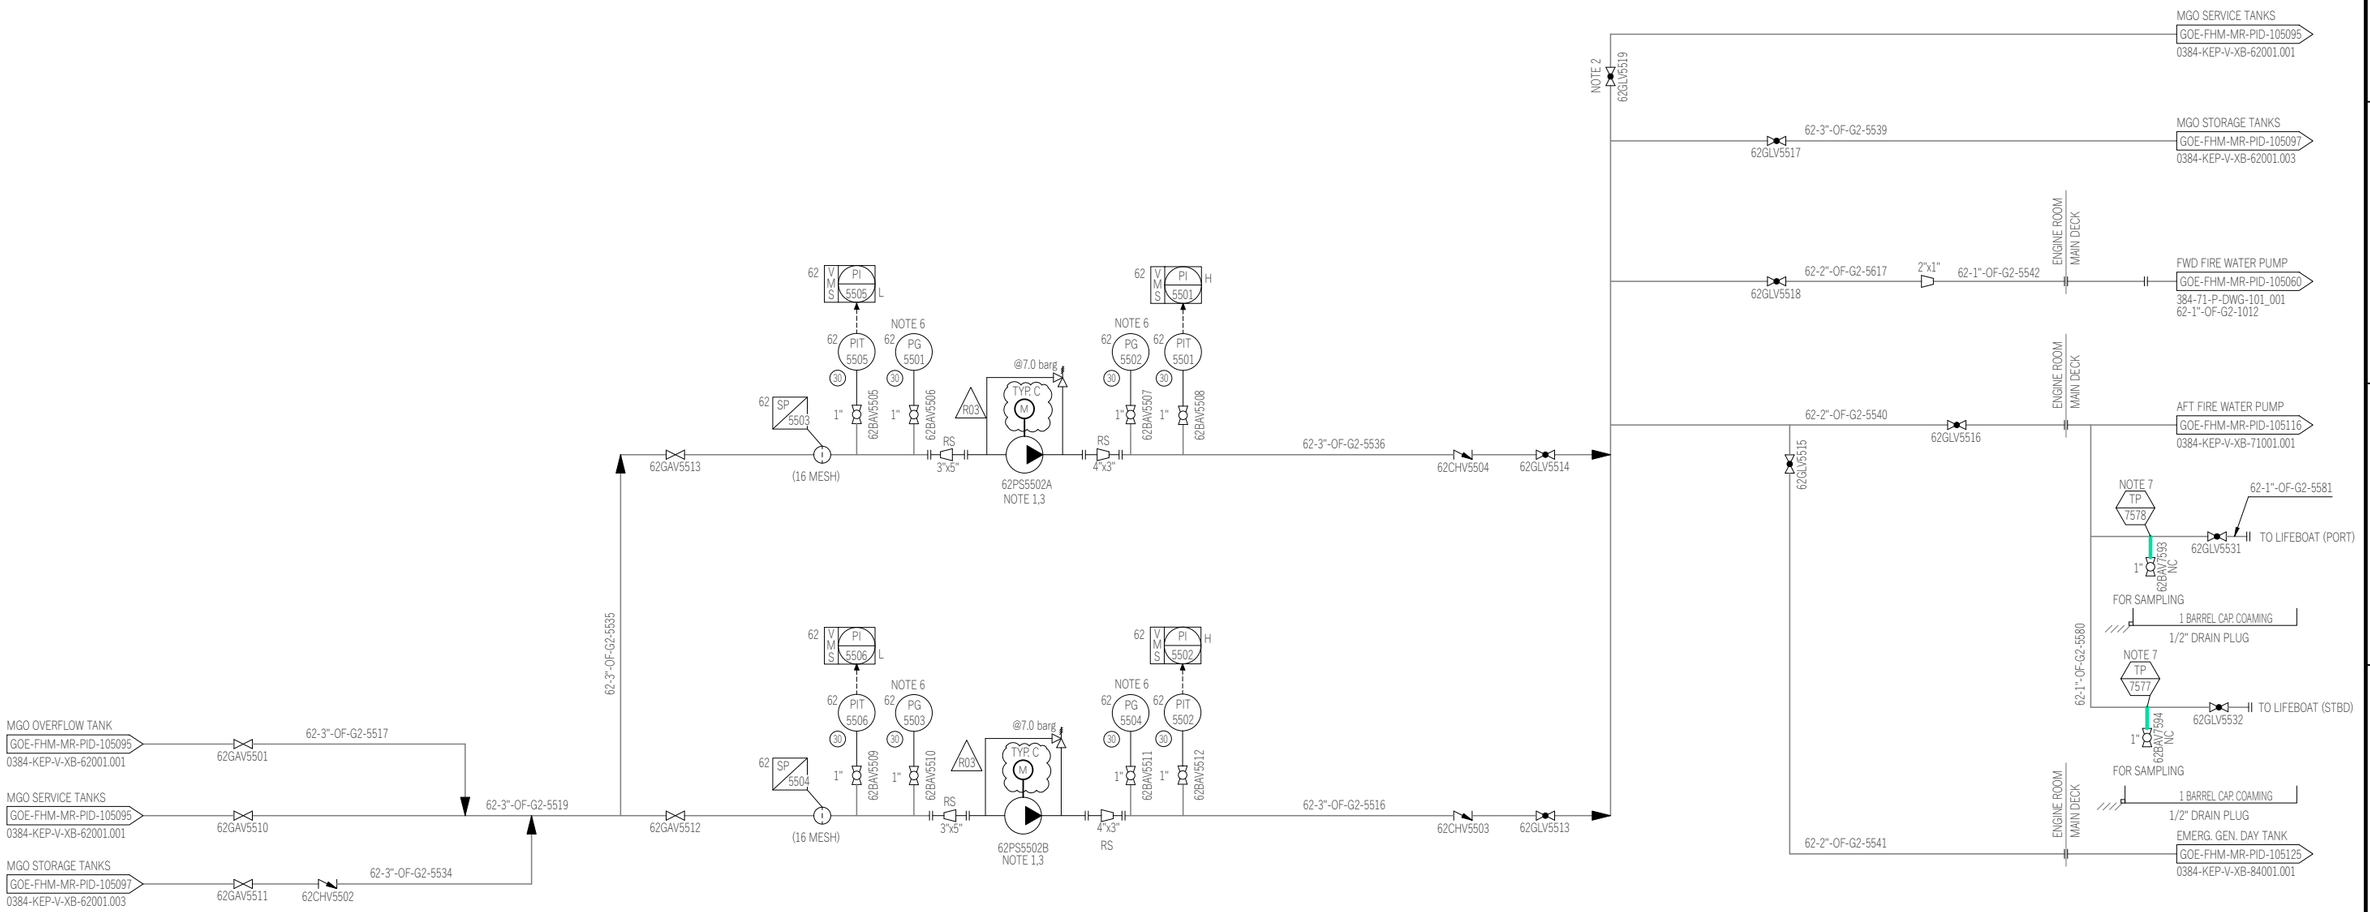

GENERAL NOTES:

1. THIS P&ID IS REISSUED FOR INFORMATION FOR SAKARYA PROJECT.
2. NO CHANGE IN SYSTEM.
3. FOR P&ID LEGEND SHEET SEE DRAWING:
 SC26-2A-GOE-FGN-PE-PID-100018, SC26-2A-GOE-FGN-PE-PID-100021 TO 100031.
4. FOR MARINE PIPING AND VALVE MATERIAL SPECIFICATION, SEE DOCUMENT:
 SC26-2A-GOE-FHM-EP-SPC-105001 (4517-BWO-L-SA-00002).

R03 5. FOR CHANGES IN REV.03, PLEASE REFER TO ECN-00317.

NOTES:

1. PUMP MOTOR STARTER CONNECTION TYPICAL DETAILS REFER TO P&ID SYMBOLS AND LEGEND.
2. VALVE TO BE THROTTLED IF REQUIRED, WHEN FILLING OF FWD FIRE PUMP DAY TANK, LIFE BOAT FROM MGO SERVICE TANK.
3. EMERGENCY STOP FOR INDIVIDUAL TRANSFER PUMP ARE LOCATED LOCALLY AND ALSO AT LIFEBOATS (PORT & STBD).
4. ANTI SPLASHING TAPE TO BE PROVIDED FOR ALL FLANGES WITHIN THE MGO SYSTEM.
5. DELETED.
6. VENDOR SUPPLY.
7. NEW PIPE INSERTING POINT TO FOLLOW SITE CONDITION.

LEGENDS:

EXISTING PIPE

NEW PIPE

GOE REV.	OTC REV.	REASON FOR USE	DATE	DRAWN	ISSUED	CHECKED	APPROVED
-	R03	ISSUED FOR INFORMATION	03/12/25	ZYL	DWJ	DC	SJL
-	R02	ISSUED FOR INFORMATION	10/09/25	ZYL	DWJ	DC	SJL
-	R01	ISSUED FOR INFORMATION	14/05/25	ZYL	DWJ	DC	SJL
-	R00	ISSUED FOR INFORMATION (1st GOE ISSUE)	31/12/24	ZYL	DWJ	DC	SJL
Z0	-	ISSUED FOR AS-BUILT	28/09/22	JT	JT	NO	PL
02	-	RE-ISSUED FOR CONSTRUCTION	03/02/21	XH	JT	NO	PL
01	-	RE-ISSUED FOR CONSTRUCTION	18/12/19	XH	JT	NO	PL
00	-	ISSUED FOR CONSTRUCTION	29/08/19	XH	JT	NO	PL
C	-	ISSUED FOR DESIGN	10/05/19	XH	JT	NO	PL
B	-	ISSUED FOR APPROVAL	06/03/19	TT	JT	NO	PL
A	-	ISSUED FOR IDC	15/02/19	TT	JT	NO	PL

DISCIPLINE:	SYSTEM NO:	AREA / MODULE:	IMO NO:	PROJECT NO:	SCALE:	SIZE:
MR	62	FHM	8706014	SC26-2A	N.T.S.	A3

SUPPLIER: OceanSTAR Elite / GOE GLOBAL OFFSHORE ENGINEERING

PROJECT: Sakarya Gas Field Dev't Phase-2a

TITLE: P&ID - MGO TRANSFER SYSTEM (SHEET 2)

CLIENT: TP OTC OFFSHORE TECHNOLOGY CENTER

OTC DOC. NO:	SC26-2A-GOE-FHM-MR-PID-105096	GOE REV.	SHEET
LEG DOC. NO:	-	-	2 of 3
REF. DOC. NO:	0384-KEP-V-XB-62001.002	OTC REV.	
		R03	

This drawing contains proprietary information and may not be transferred, reproduced or used to construct any project other than it was issued for without the written consent of GOE or their Client.