
EQUIP. TAG	82EG5501A
EQUIP. NAME	ESSENTIAL GENERATOR A
CONFIGURATION	3 X 50%
ENGINE OUTPUT	1200 ekW

EQUIP. TAG	82EG5501A-DD01
EQUIP. NAME	ESSENTIAL GENERATOR A ENGINE
CONFIGURATION	3 X 50%
ENGINE OUTPUT	1302kWm @ 1800RPM

82EG5501A INTERFACE		
TP	DESCRIPTION	CONNECTION TYPE / SIZE
F1	FUEL INLET	1"
F2	FUEL RETURN TO TANK	1"
L4	LUB OIL INLET	1"
L2	DRIP PAN DRAIN	1"
L3	LUBE OIL DRAIN	1"
E1	EXHAUST OUTLET	12" RF
B1	CRANKCASE BREATHER	1"
B2	CRANKCASE BREATHER	1"
H1	ALTERNATOR COOLING FRESHWATER INLET	1 1/4"
H2	ALTERNATOR COOLING FRESHWATER OUTLET	1 1/4"
H3	ENGINE COOLING FRESHWATER INLET	3" FF
H4	ENGINE COOLING FRESHWATER OUTLET	3" FF
D1	SILENCER DRAIN	1" BSP

EQUIP. TAG	56TB5502
EQUIP. NAME	EXHAUST DRAIN TANK
CAPACITY	0.28 m3
CONFIGURATION	1 x 100%
OPERATING(DESIGN) PRESSURE	ATM (ATM) BARG
MATERIAL	CARBON STEEL

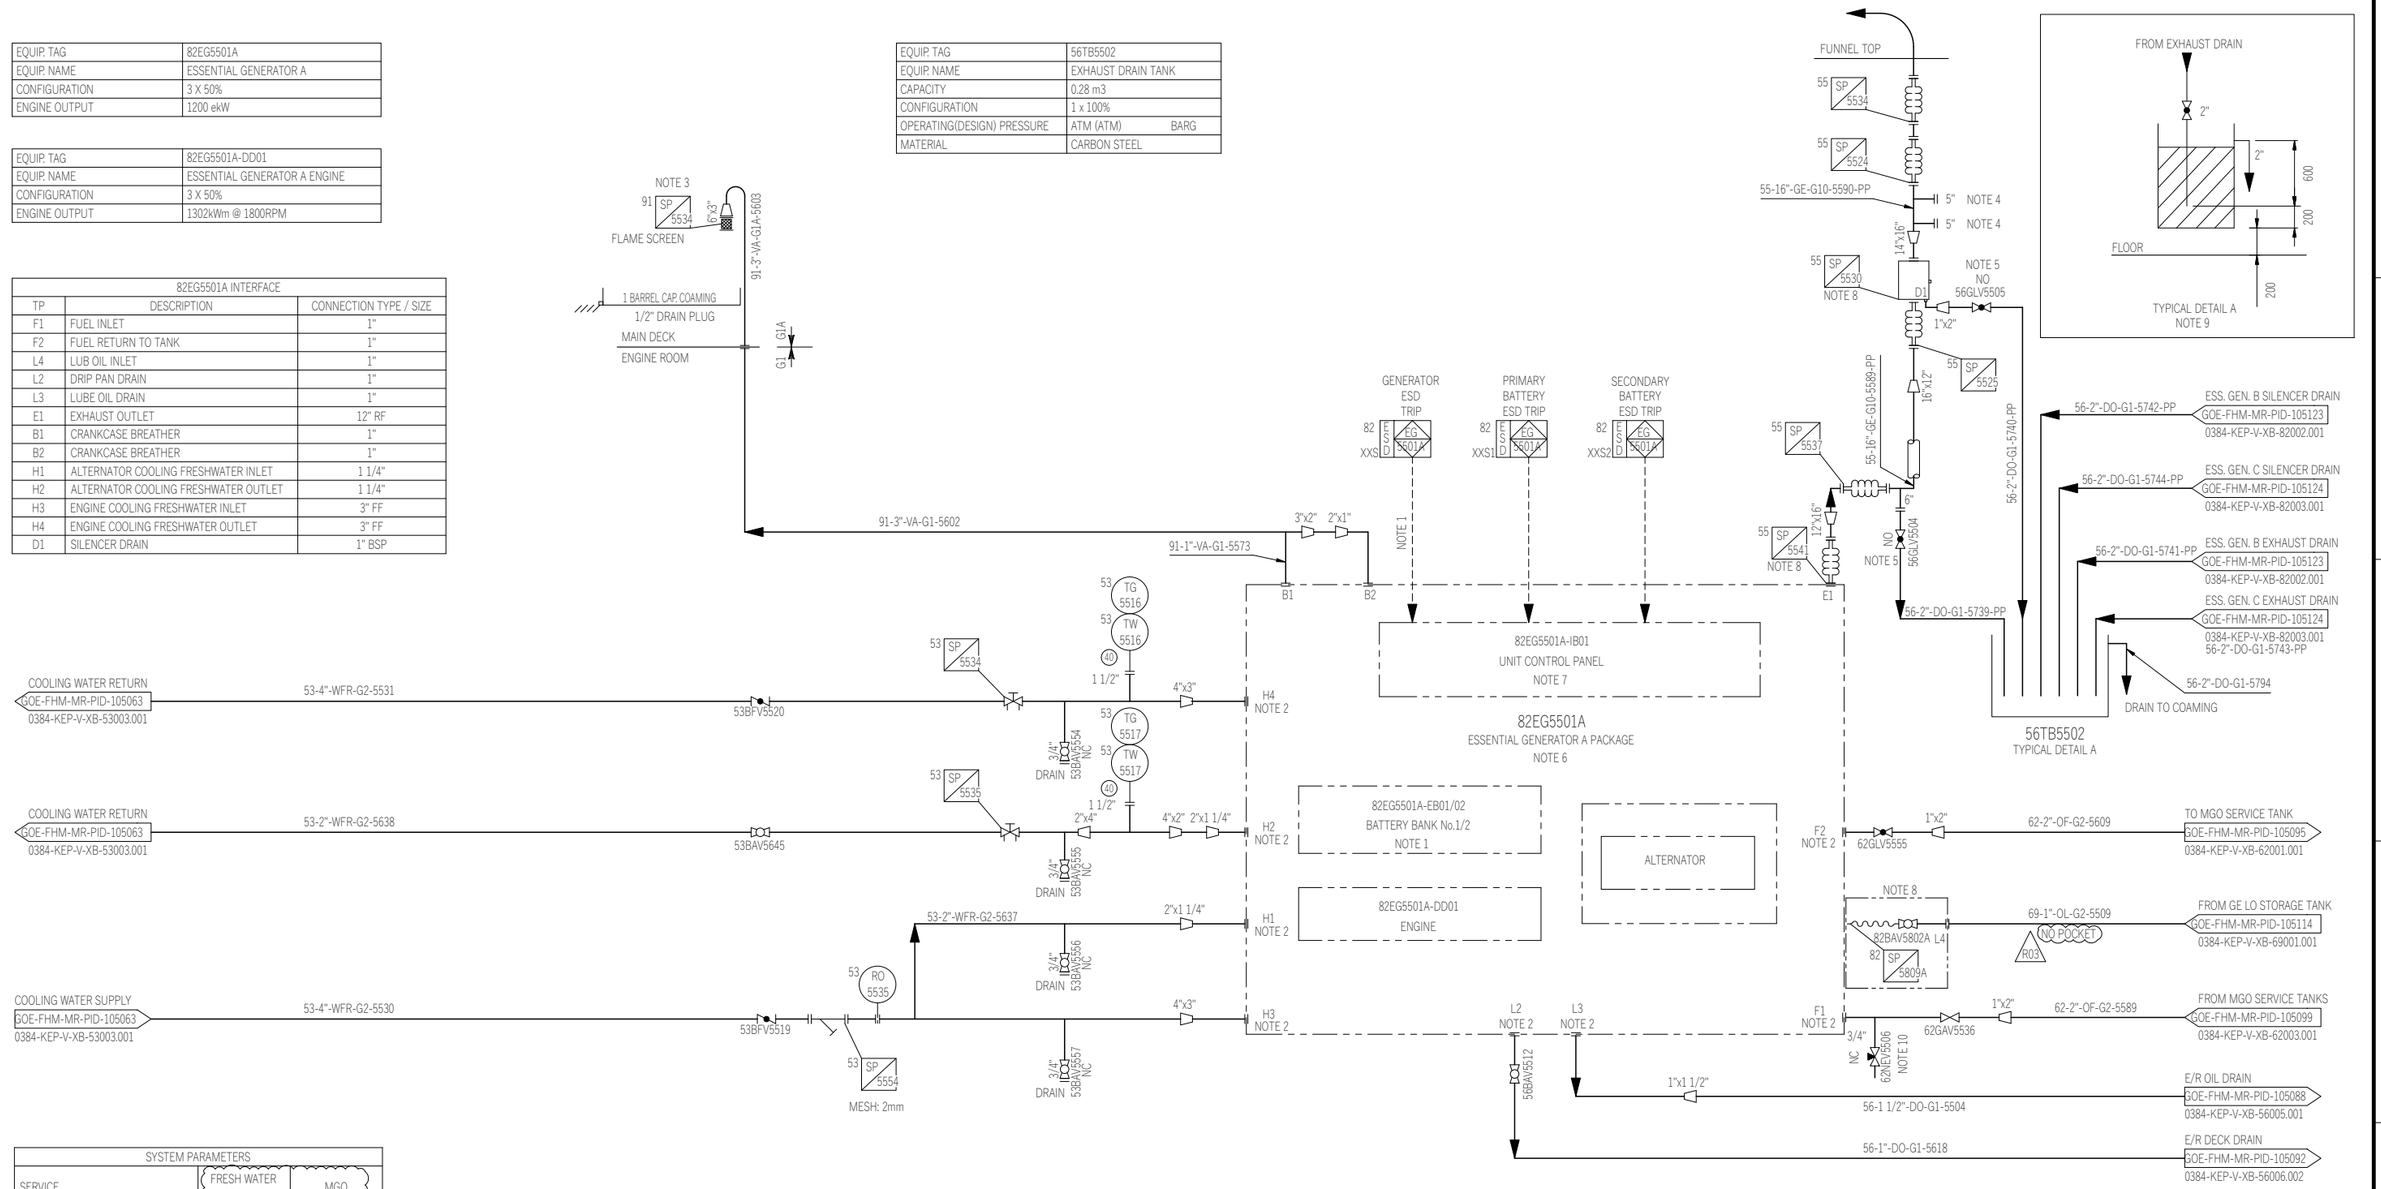

SYSTEM PARAMETERS		
SERVICE	FRESH WATER COOLING	MGO
DESIGN PRESSURE(Barg)	8.0	7.0
OPERATING PRESSURE(Barg)	6.0	6.0
DESIGN TEMPERATURE(°C)	65.0	60.0
OPERATING TEMPERATURE,(°C)	AVG. 44	54.0

R03

NOTES:

1. ESD 2.1 WILL TRIP ESSENTIAL GENERATOR BATTERY BANKS.
2. FLEXIBLE CONNECTION TO BE PROVIDED BY GENSET VENDOR.
3. WEATHER PROOF FLAME SCREEN.
4. SAMPLING POINT TO USE 5" BS10 FLANGE.
5. VALVE TO BE OPERABLE FROM FLOOR LEVEL.
6. REFER TO VENDOR DRAWING 0384-CSS-V-XB-82002.001 FOR GENERATOR P&ID AND 0384-CSS-V-XE-00001.001 FOR GA LAYOUT.
7. FOR SIGNALS BETWEEN ICSS AND VENDOR PACKAGE, REFER TO 0384-KEP-I-LA-00008.
8. VENDOR SUPPLY.
9. REFER TO 0384-KEP-N-XG-00022.001 FOR EXHAUST DRAIN TANK DETAILS.
10. SAMPLING POINT TO BE CLEARLY MARKED ON SITE. REFER TO IMO RULE MEPC.1/CIRC.864/REV.1.

R03

GENERAL NOTES:

1. THIS P&ID IS REISSUED FOR INFORMATION FOR SAKARYA PROJECT.
2. NO CHANGE IN SYSTEM.
3. FOR P&ID LEGEND SHEET SEE DRAWING: SC26-2A-GOE-FHM-MR-PID-105133 TO 105139.

R03

4. FOR MARINE PIPING AND VALVE MATERIAL SPECIFICATION, SEE DOCUMENT: SC26-2A-GOE-FHM-EP-SPC-105001 (4517-BWO-I-SA-00002).

R03

5. FOR CHANGES IN REV.03, PLEASE REFER TO ECN-00336, ECN-00344.

LEGENDS:

EXISTING PIPE

INSULATED PIPE

-	R03	ISSUED FOR INFORMATION	09/04/26	ZYL	DWJ	DC	SJL
-	R02	ISSUED FOR INFORMATION	15/09/25	ZYL	DWJ	DC	SJL
-	R01	ISSUED FOR INFORMATION	24/06/25	ZYL	DWJ	DC	SJL
-	R00	ISSUED FOR INFORMATION (1ST GOE ISSUE)	13/01/25	ZYL	DWJ	DC	SJL
Z0	-	ISSUED FOR AS-BUILT	28/09/22	JT	JT	NO	PL
02	-	RE-ISSUED FOR CONSTRUCTION	07/04/21	XH	JT	NO	PL
01	-	RE-ISSUED FOR CONSTRUCTION	18/09/20	XH	JT	NO	PL
00	-	ISSUED FOR CONSTRUCTION	23/12/19	XH	JT	NO	PL
C	-	ISSUED FOR DESIGN	08/08/19	XH	JT	NO	PL
B	-	ISSUED FOR REVIEW	18/07/19	XH	JT	NO	PL
A	-	ISSUED FOR IDC	01/07/19	XH	JT	NO	PL
GOE REV.	OTC REV.	REASON FOR USE	DATE	DRAWN	ISSUED	CHECKED	APPROVED

DISCIPLINE:	SYSTEM NO:	AREA / MODULE:	IMO NO:	PROJECT NO:	SCALE:	SIZE:
MR	82	FHM	8706014	SC26-2A	N.T.S.	A3

SUPPLIER: OceanSTAR Elite

GOE GLOBAL OFFSHORE ENGINEERING

PROJECT: Sakarya Gas Field Dev't Phase-2a

TITLE: P&ID - ESSENTIAL GENERATOR ENGINE A

CLIENT: TP OTC OFFSHORE TECHNOLOGY CENTER

OTC DOC. NO:	SC26-2A-GOE-FHM-MR-PID-105122	GOE REV.	SHEET
LEG DOC. NO:	-	-	1 of 1
REF. DOC. NO:	0384-KEP-V-XB-82001.001	OTC REV.	
		R03	

This drawing contains proprietary information and may not be transferred, reproduced or used to construct any project other than it was issued for without the written consent of GOE or their Client.