EQUIP. TAG	65TB5504
EQUIP. NAME	HYDRAULIC OIL STORAGE TANK
CAPACITY	1 M3
CONFIGURATION	1 x 100%
WORKING(DESIGN) PRESSURE	ATM (ATM) BARG
MATERIAL	CARBON STEEL

EQUIP. TAG	65PR5502
EQUIP. NAME	HYDRAULIC HAND PUMP
CONFIGURATION	1 x 100%

EQUIP. TAG	65PX5503
EQUIP. NAME	PORTABLE HAND PUMP
CONFIGURATION	1 x 100%

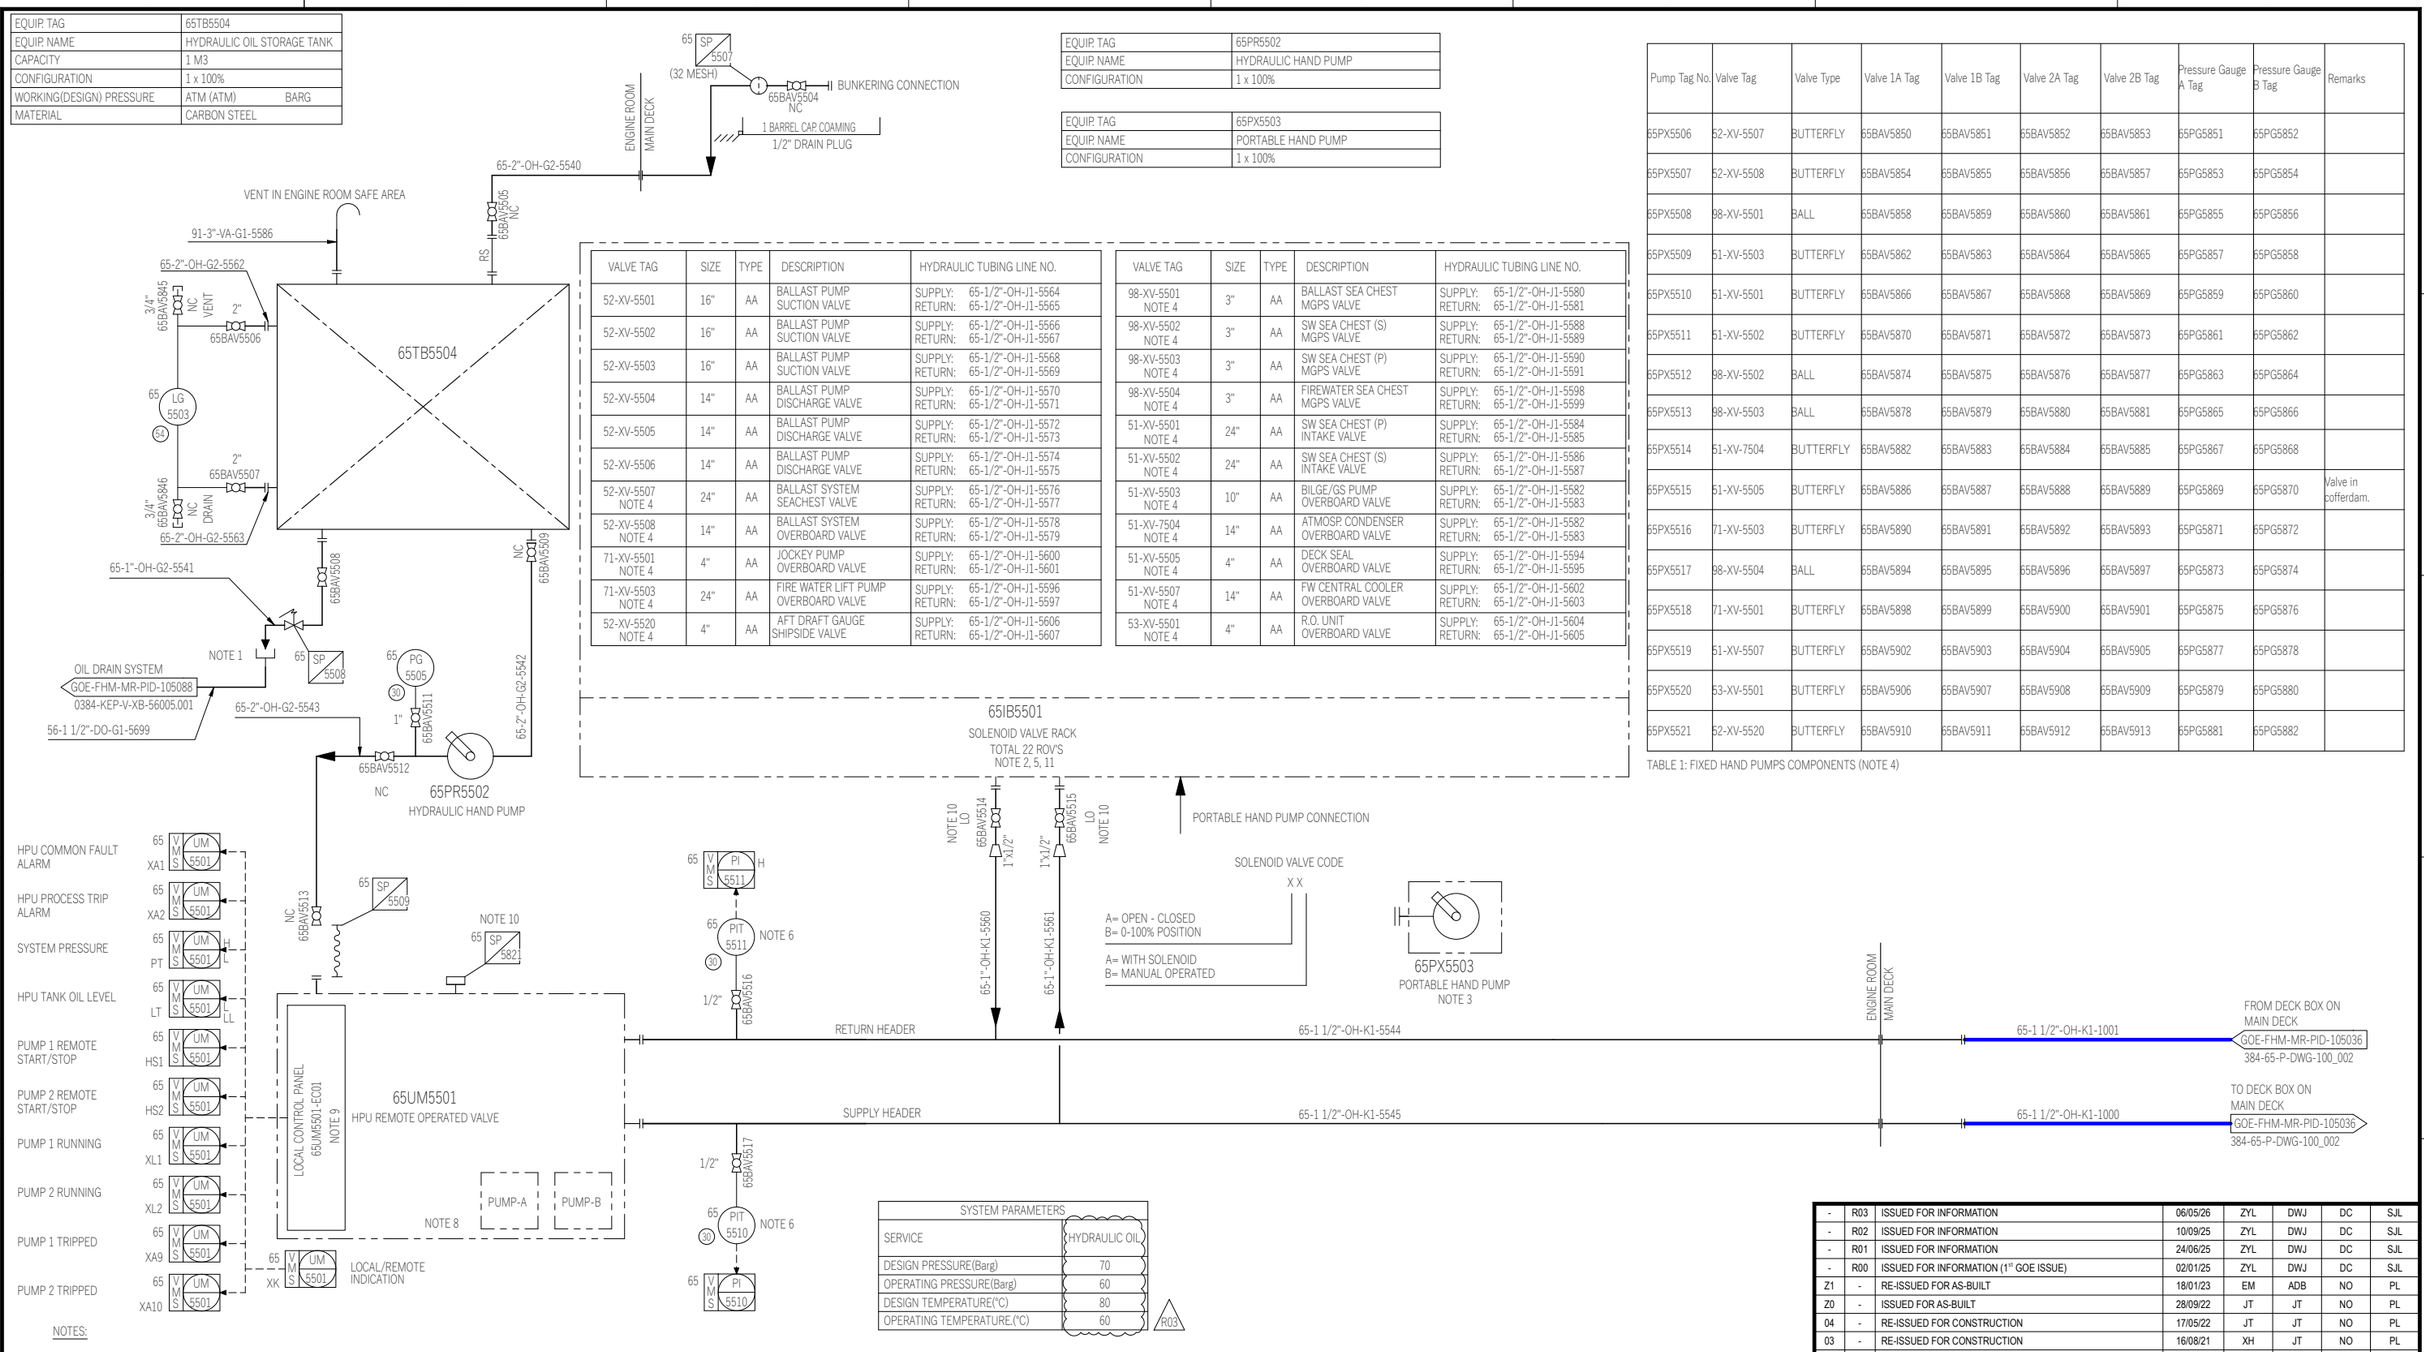

VALVE TAG	SIZE	TYPE	DESCRIPTION	HYDRAULIC TUBING LINE NO.
52-XV-5501	16"	AA	BALLAST PUMP SUCTION VALVE	SUPPLY: 65-1/2"-OH-J1-5564 RETURN: 65-1/2"-OH-J1-5565
52-XV-5502	16"	AA	BALLAST PUMP SUCTION VALVE	SUPPLY: 65-1/2"-OH-J1-5566 RETURN: 65-1/2"-OH-J1-5567
52-XV-5503	16"	AA	BALLAST PUMP SUCTION VALVE	SUPPLY: 65-1/2"-OH-J1-5568 RETURN: 65-1/2"-OH-J1-5569
52-XV-5504	14"	AA	BALLAST PUMP DISCHARGE VALVE	SUPPLY: 65-1/2"-OH-J1-5570 RETURN: 65-1/2"-OH-J1-5571
52-XV-5505	14"	AA	BALLAST PUMP DISCHARGE VALVE	SUPPLY: 65-1/2"-OH-J1-5572 RETURN: 65-1/2"-OH-J1-5573
52-XV-5506	14"	AA	BALLAST PUMP DISCHARGE VALVE	SUPPLY: 65-1/2"-OH-J1-5574 RETURN: 65-1/2"-OH-J1-5575
52-XV-5507 NOTE 4	24"	AA	BALLAST SYSTEM SEACHEST VALVE	SUPPLY: 65-1/2"-OH-J1-5576 RETURN: 65-1/2"-OH-J1-5577
52-XV-5508 NOTE 4	14"	AA	BALLAST SYSTEM OVERBOARD VALVE	SUPPLY: 65-1/2"-OH-J1-5578 RETURN: 65-1/2"-OH-J1-5579
71-XV-5501 NOTE 4	4"	AA	JOCKEY PUMP OVERBOARD VALVE	SUPPLY: 65-1/2"-OH-J1-5600 RETURN: 65-1/2"-OH-J1-5601
71-XV-5503 NOTE 4	24"	AA	FIRE WATER LIFT PUMP OVERBOARD VALVE	SUPPLY: 65-1/2"-OH-J1-5596 RETURN: 65-1/2"-OH-J1-5597
52-XV-5520 NOTE 4	4"	AA	AFT DRAFT GAUGE SHIPSIDE VALVE	SUPPLY: 65-1/2"-OH-J1-5606 RETURN: 65-1/2"-OH-J1-5607

VALVE TAG	SIZE	TYPE	DESCRIPTION	HYDRAULIC TUBING LINE NO.
98-XV-5501 NOTE 4	3"	AA	BALLAST SEA CHEST MGPS VALVE	SUPPLY: 65-1/2"-OH-J1-5580 RETURN: 65-1/2"-OH-J1-5581
98-XV-5502 NOTE 4	3"	AA	SW SEA CHEST (S) MGPS VALVE	SUPPLY: 65-1/2"-OH-J1-5588 RETURN: 65-1/2"-OH-J1-5589
98-XV-5503 NOTE 4	3"	AA	SW SEA CHEST (P) MGPS VALVE	SUPPLY: 65-1/2"-OH-J1-5590 RETURN: 65-1/2"-OH-J1-5591
98-XV-5504 NOTE 4	3"	AA	FIREWATER SEA CHEST MGPS VALVE	SUPPLY: 65-1/2"-OH-J1-5598 RETURN: 65-1/2"-OH-J1-5599
51-XV-5501 NOTE 4	24"	AA	SW SEA CHEST (P) INTAKE VALVE	SUPPLY: 65-1/2"-OH-J1-5584 RETURN: 65-1/2"-OH-J1-5585
51-XV-5502 NOTE 4	24"	AA	SW SEA CHEST (S) INTAKE VALVE	SUPPLY: 65-1/2"-OH-J1-5586 RETURN: 65-1/2"-OH-J1-5587
51-XV-5503 NOTE 4	10"	AA	BILGE/GS PUMP OVERBOARD VALVE	SUPPLY: 65-1/2"-OH-J1-5582 RETURN: 65-1/2"-OH-J1-5583
51-XV-7504 NOTE 4	14"	AA	ATMOSP. CONDENSER OVERBOARD VALVE	SUPPLY: 65-1/2"-OH-J1-5582 RETURN: 65-1/2"-OH-J1-5583
51-XV-5505 NOTE 4	4"	AA	DECK SEAL OVERBOARD VALVE	SUPPLY: 65-1/2"-OH-J1-5594 RETURN: 65-1/2"-OH-J1-5595
51-XV-5507 NOTE 4	14"	AA	FW CENTRAL COOLER OVERBOARD VALVE	SUPPLY: 65-1/2"-OH-J1-5602 RETURN: 65-1/2"-OH-J1-5603
53-XV-5501 NOTE 4	4"	AA	R.O. UNIT OVERBOARD VALVE	SUPPLY: 65-1/2"-OH-J1-5604 RETURN: 65-1/2"-OH-J1-5605

SYSTEM PARAMETERS	
SERVICE	HYDRAULIC OIL
DESIGN PRESSURE(Barg)	70
OPERATING PRESSURE(Barg)	60
DESIGN TEMPERATURE(°C)	80
OPERATING TEMPERATURE.(°C)	60

R03

Pump Tag No.	Valve Tag	Valve Type	Valve 1A Tag	Valve 1B Tag	Valve 2A Tag	Valve 2B Tag	Pressure Gauge A Tag	Pressure Gauge B Tag	Remarks
65PX5506	52-XV-5507	BUTTERFLY	65BAV5850	65BAV5851	65BAV5852	65BAV5853	65PG5851	65PG5852	
65PX5507	52-XV-5508	BUTTERFLY	65BAV5854	65BAV5855	65BAV5856	65BAV5857	65PG5853	65PG5854	
65PX5508	98-XV-5501	BALL	65BAV5858	65BAV5859	65BAV5860	65BAV5861	65PG5855	65PG5856	
65PX5509	51-XV-5503	BUTTERFLY	65BAV5862	65BAV5863	65BAV5864	65BAV5865	65PG5857	65PG5858	
65PX5510	51-XV-5501	BUTTERFLY	65BAV5866	65BAV5867	65BAV5868	65BAV5869	65PG5859	65PG5860	
65PX5511	51-XV-5502	BUTTERFLY	65BAV5870	65BAV5871	65BAV5872	65BAV5873	65PG5861	65PG5862	
65PX5512	98-XV-5502	BALL	65BAV5874	65BAV5875	65BAV5876	65BAV5877	65PG5863	65PG5864	
65PX5513	98-XV-5503	BALL	65BAV5878	65BAV5879	65BAV5880	65BAV5881	65PG5865	65PG5866	
65PX5514	51-XV-7504	BUTTERFLY	65BAV5882	65BAV5883	65BAV5884	65BAV5885	65PG5867	65PG5868	
65PX5515	51-XV-5505	BUTTERFLY	65BAV5886	65BAV5887	65BAV5888	65BAV5889	65PG5869	65PG5870	Valve in cofferdam.
65PX5516	71-XV-5503	BUTTERFLY	65BAV5890	65BAV5891	65BAV5892	65BAV5893	65PG5871	65PG5872	
65PX5517	98-XV-5504	BALL	65BAV5894	65BAV5895	65BAV5896	65BAV5897	65PG5873	65PG5874	
65PX5518	71-XV-5501	BUTTERFLY	65BAV5898	65BAV5899	65BAV5900	65BAV5901	65PG5875	65PG5876	
65PX5519	51-XV-5507	BUTTERFLY	65BAV5902	65BAV5903	65BAV5904	65BAV5905	65PG5877	65PG5878	
65PX5520	53-XV-5501	BUTTERFLY	65BAV5906	65BAV5907	65BAV5908	65BAV5909	65PG5879	65PG5880	
65PX5521	52-XV-5520	BUTTERFLY	65BAV5910	65BAV5911	65BAV5912	65BAV5913	65PG5881	65PG5882	

TABLE 1: FIXED HAND PUMPS COMPONENTS (NOTE 4)

NOTES:

1. DRAIN DIRECTLY TO HOPPER.
2. LOCATION ENGINE ROOM 1ST PLATFORM, SAFE AREA.
3. PORTABLE HAND PUMP (65PX5503) IS PROVIDED FOR MANUAL OPERATING IN CASE OF SYSTEM FAILURE.
4. LOCAL MANUAL OPERATION BY FIXED HAND PUMP. REFER TO 0384-BLP-V-XE-00004 FOR FIXED HAND PUMP DETAILS.
5. TUBING BETWEEN SOLENOID RACK AND VALVE ACTUATORS TO BE 1/2" TUBING AS PER J1 PIPING SPECIFICATION.
6. CONNECTION FROM SAE BALL VALVE TO PIT TO BE 1/2" NPT THREADED SAE FLANGE.
7. FLANGES SHALL BE LIMITED TO PENETRATIONS, TIE-INS & VALVE JOINTS.
8. REFER TO VENDOR P&ID 0384-BLP-V-XB-65001.001 FOR HPU DETAILS.
9. FOR SIGNALS BETWEEN ICSS AND VENDOR PACKAGE, REFER TO 0384-KEP-I-LA-00008.
10. VENDOR SUPPLY.
11. REFER TO VENDOR P&ID 0384-BLP-V-XB-65002.001 FOR SOLENOID VALVE RACK DETAILS.

GENERAL NOTES:

1. THIS P&ID IS REISSUED FOR INFORMATION FOR SAKARYA PROJECT.
2. NO CHANGE IN SYSTEM.
3. FOR P&ID LEGEND SHEET SEE DRAWING: SC26-2A-GOE-FHM-MR-PID-105133 TO 105139. R03
4. FOR MARINE PIPING AND VALVE MATERIAL SPECIFICATION, SEE DOCUMENT: SC26-2A-GOE-FHM-EP-SPC-105001 (4517-BWO-I-SA-00002).
5. FOR CHANGES IN REV.03, PLEASE REFER TO ECN-00415. R03

LEGENDS:

EXISTING PIPE

LIKE TO LIKE REPLACEMENT PIPE

EQUIP. TAG	65UM5501
EQUIP. NAME	HPU REMOTE OPERATED VALVE
CONFIGURATION	1 x 100%
WORKING(DESIGN) PRESSURE	60 (70) BARG

pressure not correct
operat pressure to be checked, it should be 60-140barg, 20lpm per pump

GOE REV.	OTC REV.	REASON FOR USE	DATE	DRAWN	ISSUED	CHECKED	APPROVED
-	R03	ISSUED FOR INFORMATION	06/05/26	ZYL	DWJ	DC	SJL
-	R02	ISSUED FOR INFORMATION	10/09/25	ZYL	DWJ	DC	SJL
-	R01	ISSUED FOR INFORMATION	24/06/25	ZYL	DWJ	DC	SJL
-	R00	ISSUED FOR INFORMATION (1st GOE ISSUE)	02/01/25	ZYL	DWJ	DC	SJL
Z1	-	RE-ISSUED FOR AS-BUILT	18/01/23	EM	ADB	NO	PL
Z0	-	ISSUED FOR AS-BUILT	28/09/22	JT	JT	NO	PL
04	-	RE-ISSUED FOR CONSTRUCTION	17/05/22	JT	JT	NO	PL
03	-	RE-ISSUED FOR CONSTRUCTION	16/08/21	XH	JT	NO	PL
02	-	RE-ISSUED FOR CONSTRUCTION	07/04/21	XH	JT	NO	PL
01	-	RE-ISSUED FOR CONSTRUCTION	24/11/20	TXH	JT	NO	PL
00	-	ISSUED FOR CONSTRUCTION	23/03/20	TXH	JT	NO	PL
C	-	ISSUED FOR DESIGN	23/10/19	ADB	JT	NO	PL
B	-	ISSUED FOR REVIEW	27/08/19	ADB	JT	NO	PL
A	-	ISSUED FOR IDC	14/07/19	ADB	JT	NO	PL

DISCIPLINE:	SYSTEM NO:	AREA / MODULE:	IMO NO:	PROJECT NO:	SCALE:	SIZE:
MR	65	FHM	8706014	SC26-2A	N.T.S.	A3

SUPPLIER: OceanSTAR Elite

GLOBAL OFFSHORE ENGINEERING

PROJECT: Sakarya Gas Field Dev't Phase-2a

TITLE: P&ID - HYDRAULIC VALVE CONTROL SYSTEM IN NEW AFT HULL

CLIENT: TP OTC OFFSHORE TECHNOLOGY CENTER

OTC DOC. NO:	SC26-2A-GOE-FHM-MR-PID-105101	GOE REV. -	SHEET 1 of 1
LEG DOC. NO:	-	OTC REV. R03	
REF. DOC. NO:	0384-KEP-V-XB-65001.001		

This drawing contains proprietary information and may not be transferred, reproduced or used to construct any project other than it was issued for without the written consent of GOE or their Client.