
EQUIP. TAG	11MK7003B
EQUIP. NAME	GYPSY MOORING WINCH (AFT)
CAPACITY	980 L/min
CONFIGURATION	1 x 100%

EQUIP. TAG	11MJ7002
EQUIP. NAME	5T CHAIN HANDLING KNUCKLE BOOM CRANE (AFT)
CAPACITY	100 L/min @ 230 bar
CONFIGURATION	1 x 100%

11MK7003B INTERFACES			
TP	DESCRIPTION	CONNECTION TYPE / SIZE	MATERIAL
P	HYDRAULIC PRESSURE	2" SAE 6000#	SS316L
T	HYDRAULIC RETURN	3" SAE 3000#	SS316L
D	HYDRAULIC DRAIN	1" SAE 3000#	SS316L

11MJ7002 & 11MJ7002-IB01 INTERFACES			
TP	DESCRIPTION	CONNECTION TYPE / SIZE	MATERIAL
P	HYDRAULIC PRESSURE	25S (EO24° CONE END FITTING)	SS316L
R	HYDRAULIC RETURN	35L (EO24° CONE END FITTING)	SS316L
D	HYDRAULIC DRAIN	18L (EO24° CONE END FITTING)	SS316L
A	HYDRAULIC OIL TO/FROM CRANE	20S OR 16S (EO24° CONE END FITTING)	SS316L
B	HYDRAULIC OIL TO/FROM CRANE	20S OR 16S (EO24° CONE END FITTING)	SS316L

SYSTEM PARAMETERS		
SERVICE	FRESH WATER COOLING	HYDRAULIC OIL
DESIGN PRESSURE(Barg)	8	300
OPERATING PRESSURE(Barg)	6	280
DESIGN TEMPERATURE(℃)	65	80
OPERATING TEMPERATURE.(℃)	AVG. 44	60

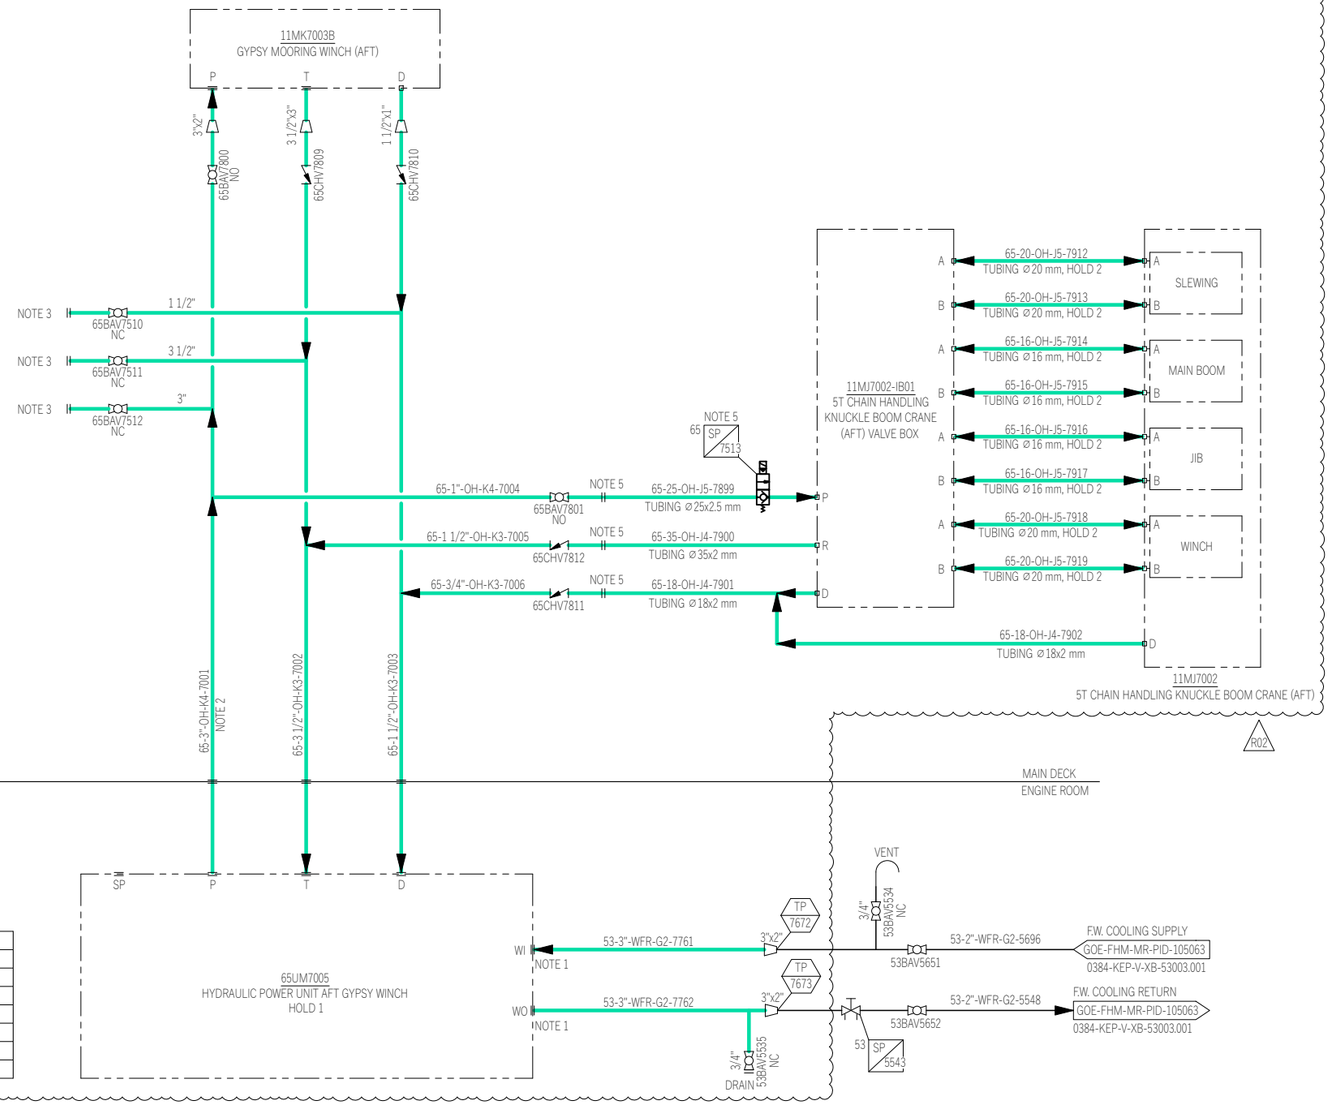

65UM7005 INTERFACES			
TP	DESCRIPTION	CONNECTION TYPE / SIZE	MATERIAL
P	HYDRAULIC PRESSURE	3" SQUARE FLANGE 6000#	SS316L
T	HYDRAULIC RETURN	3 1/2" SQUARE FLANGE 3000#	SS316L
D	HYDRAULIC DRAIN	1 1/2" SAE 4 BOLT CODE 61 3000#	SS316L
SP	SPARE PRESSURE	1 1/2" SAE 4 BOLT CODE 62 6000#	SS316L
WI	COOLING WATER IN	3" ANSI FLANGE	SS316L
WO	COOLING WATER OUT	3" ANSI FLANGE	SS316L

EQUIP. TAG	65UM7005	
EQUIP. NAME	HYDRAULIC POWER UNIT AFT GYPSY WINCH	
CAPACITY	HOLD 1	
CONFIGURATION	1 x 100%	
WORKING/DESIGN PRESSURE	280 / 300 (P), 70 (T, D) BARG	
WORKING/DESIGN TEMP.	HOLD 1	°C
DUTY POWER	HOLD 1	kW

GENERAL NOTES:

1. THIS P&ID IS REISSUED FOR INFORMATION FOR SAKARYA PROJECT.
2. DELETED.
3. FOR P&ID LEGEND SHEET SEE DRAWING: SC26-2A-GOE-FHM-MR-PID-105133 TO 105139. R02
4. FOR MARINE PIPING AND VALVE MATERIAL SPECIFICATION SEE DOCUMENT: SC26-2A-GOE-FHM-EP-SPC-105001 (4517-BWO-L-SA-00002). R02
5. PRECISE ROUTING TO BE DETERMINED ACCORDING TO SITE SITUATION FOR THE SHORTEST POSSIBLE ROUTES WITH AS LESS AS POSSIBLE OF ELBOWS AND BENDS.
6. FOR CHANGES IN REV.02, PLEASE REFER TO ECN-00464.

NOTES:

1. INSULATION KIT TO BE PROVIDED.
2. EN 10204 INSPECTION CERTIFICATE 3.1 AND 3.2 ARE REQUIRED FOR HIGH PRESSURE LINES.
3. A MANIFOLD WILL BE USED TO CONNECT THE HYDRAULIC PIPE WITH TUGGER WINCH BY SITE TEAM.
4. HYDRAULIC EMERGENCY STOP VALVE SUPPLIED BY 5T GYPSY CRANE VENDOR.
5. BLIND FLANGE WITH THREADED HOLE TO CONNECT WITH TUBING.

HOLDS:

1. EQUIPMENT INFORMATION TO BE CONFIRMED.
2. TUBING WALL THICKNESS TO BE CONFIRMED BY VENDOR.

REFERENCE:

1. FOR 5T CHAIN HANDLING KNUCKLE BOOM CRANE (AFT) AND VALVE BOX, REFER TO 26813-01-MODEL HYDRAULIC DIAGRAM KN-30 DECK CRANE.
2. FOR GYPSY MOORING WINCH (AFT), REFER TO 2129-500-00_A_GYPSY WINCH HYDRAULIC.

R02

LEGENDS:

EXISTING PIPE
NEW PIPE
HYDRAULIC EMERGENCY STOP VALVE R02

GOE REV.	OTC REV.	REASON FOR USE	DATE	DRAWN	ISSUED	CHECKED	APPROVED
-	R02	ISSUED FOR INFORMATION	12/05/26	ZYL	DWJ	DC	SJL
-	R01	ISSUED FOR INFORMATION	19/06/25	ZYL	DWJ	DC	SJL
-	R00	ISSUED FOR INFORMATION (1ST GOE ISSUE)	02/01/25	ZYL	DWJ	DC	SJL
Z0	-	ISSUED FOR AS-BUILT	28/09/22	JT	JT	NO	PL
02	-	RE-ISSUED FOR CONSTRUCTION	24/11/20	XH	JT	NO	PL
01	-	RE-ISSUED FOR CONSTRUCTION	19/12/19	XH	JT	NO	PL
00	-	ISSUED FOR CONSTRUCTION	09/10/19	XH	JT	NO	PL
C	-	ISSUED FOR DESIGN	09/07/19	CW	JT	NO	PL
B	-	ISSUED FOR REVIEW	22/04/19	CW	JT	NO	PL
A	-	ISSUED FOR IDC	29/03/19	CW	JT	NO	PL

DISCIPLINE:	SYSTEM NO:	AREA / MODULE:	IMO NO:	PROJECT NO:	SCALE:	SIZE:
MR	65	FHM	8706014	SC26-2A	N.T.S.	A3

SUPPLIER: OceanSTAR Elite / GOE GLOBAL OFFSHORE ENGINEERING

PROJECT: Sakarya Gas Field Dev't Phase-2a

TITLE: P&ID - AFT POSITION MOORING HYDRAULIC SYSTEM

CLIENT: TP OTC OFFSHORE TECHNOLOGY CENTER

OTC DOC. NO:	SC26-2A-GOE-FHM-MR-PID-105102	GOE REV.	SHEET
LEG DOC. NO:	-	-	1 of 1
REF. DOC. NO:	0384-KEP-V-XB-65002.001	OTC REV. R02	

This drawing contains proprietary information and may not be transferred, reproduced or used to construct any project other than it was issued for without the written consent of GOE or their Client.